




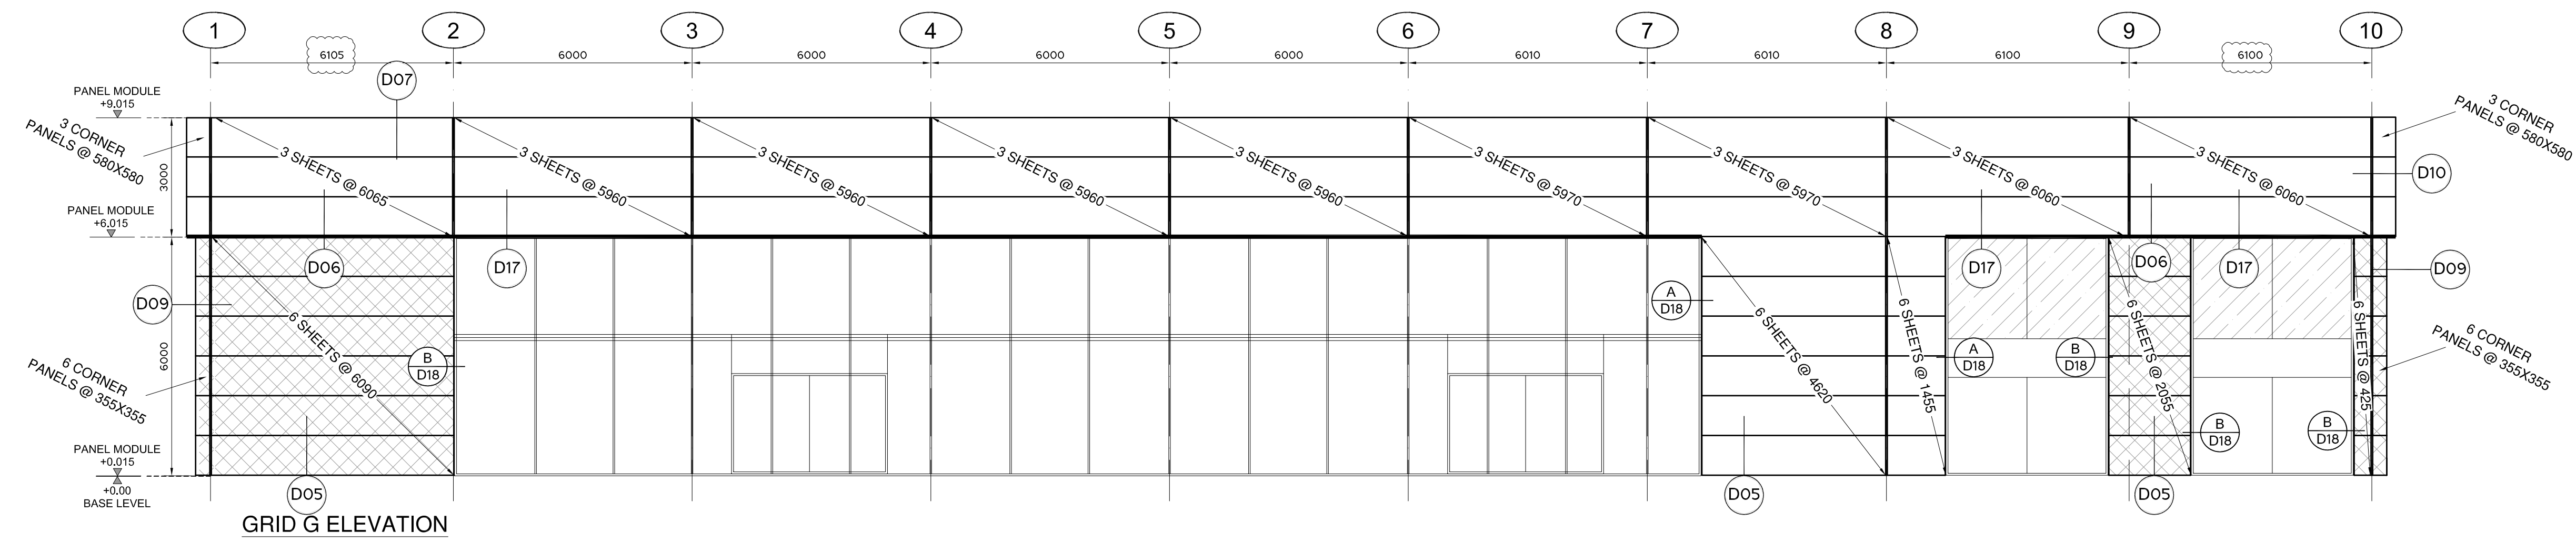


GRID G ELEVATION

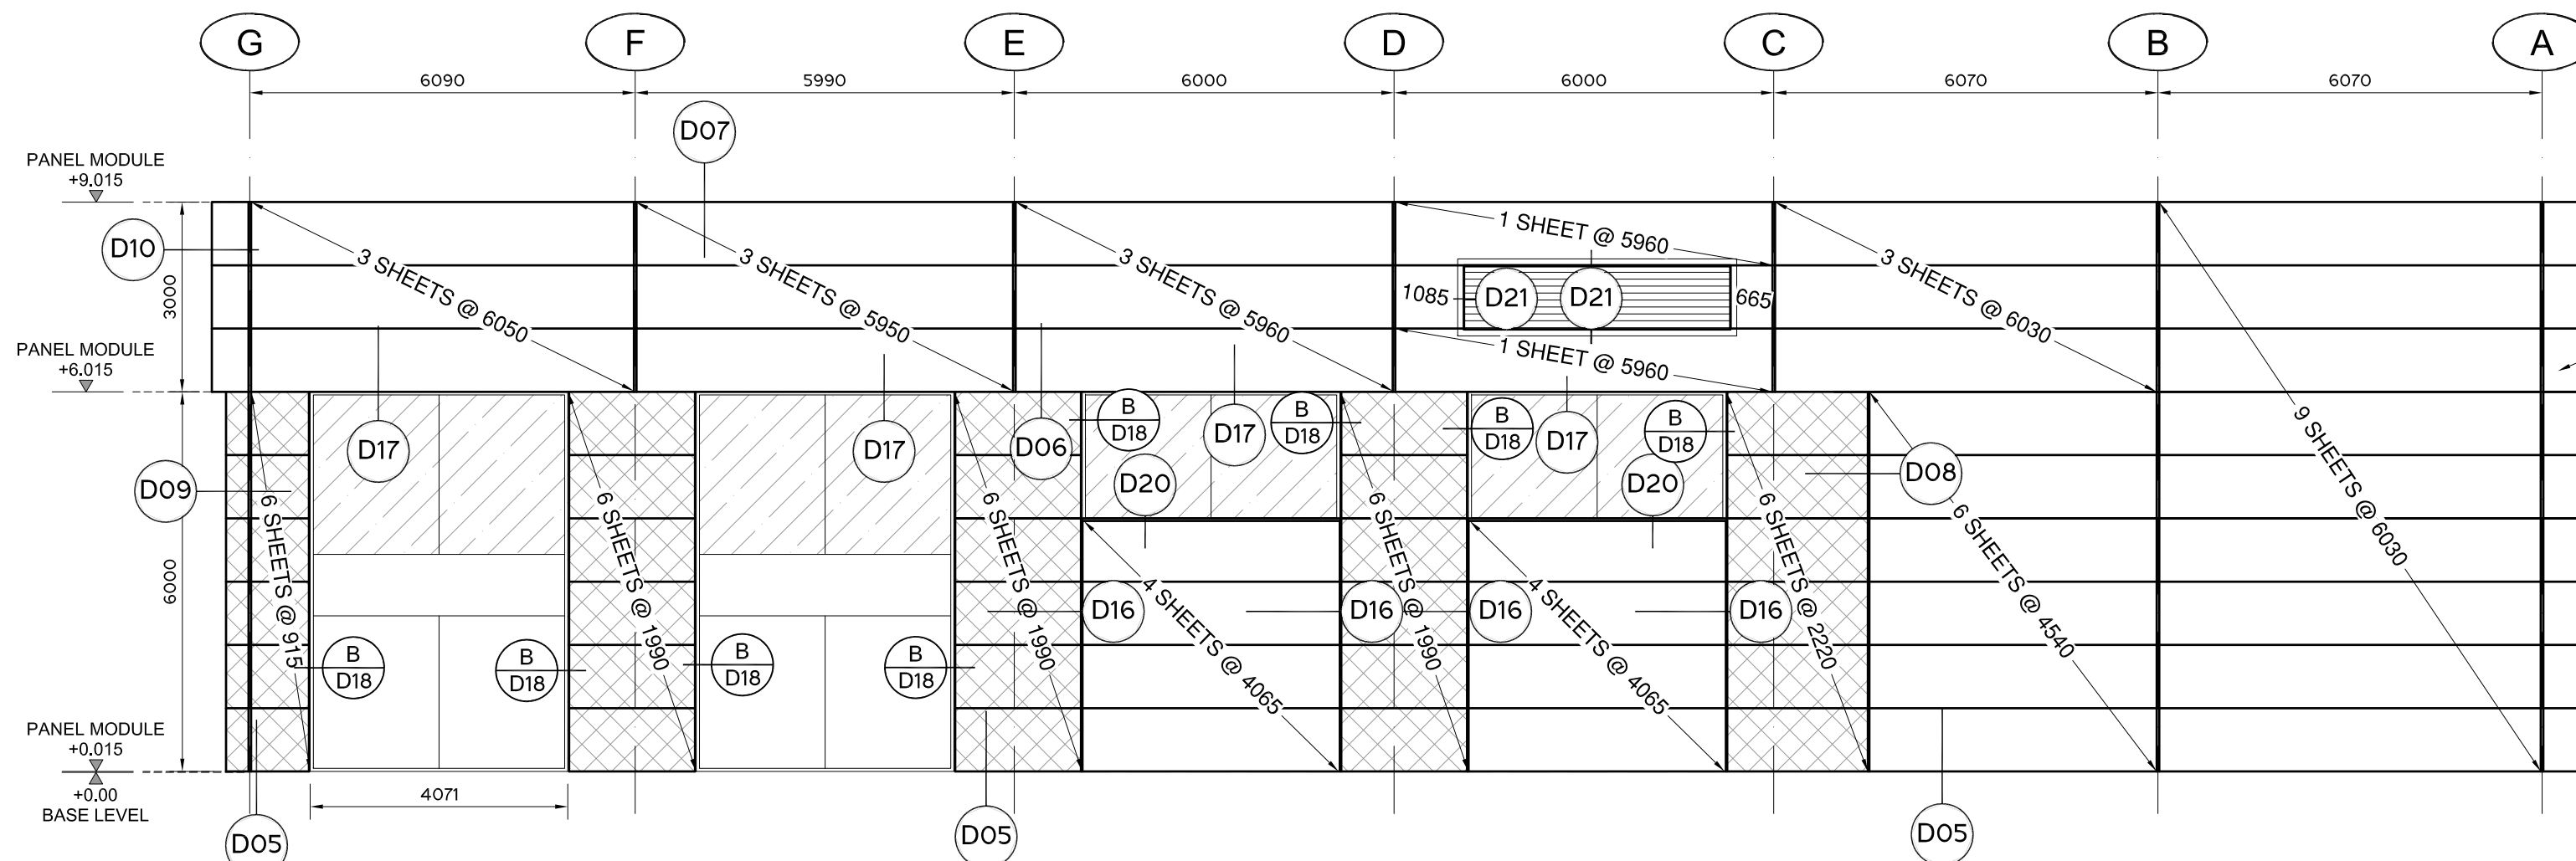


GRID 10 ELEVATION

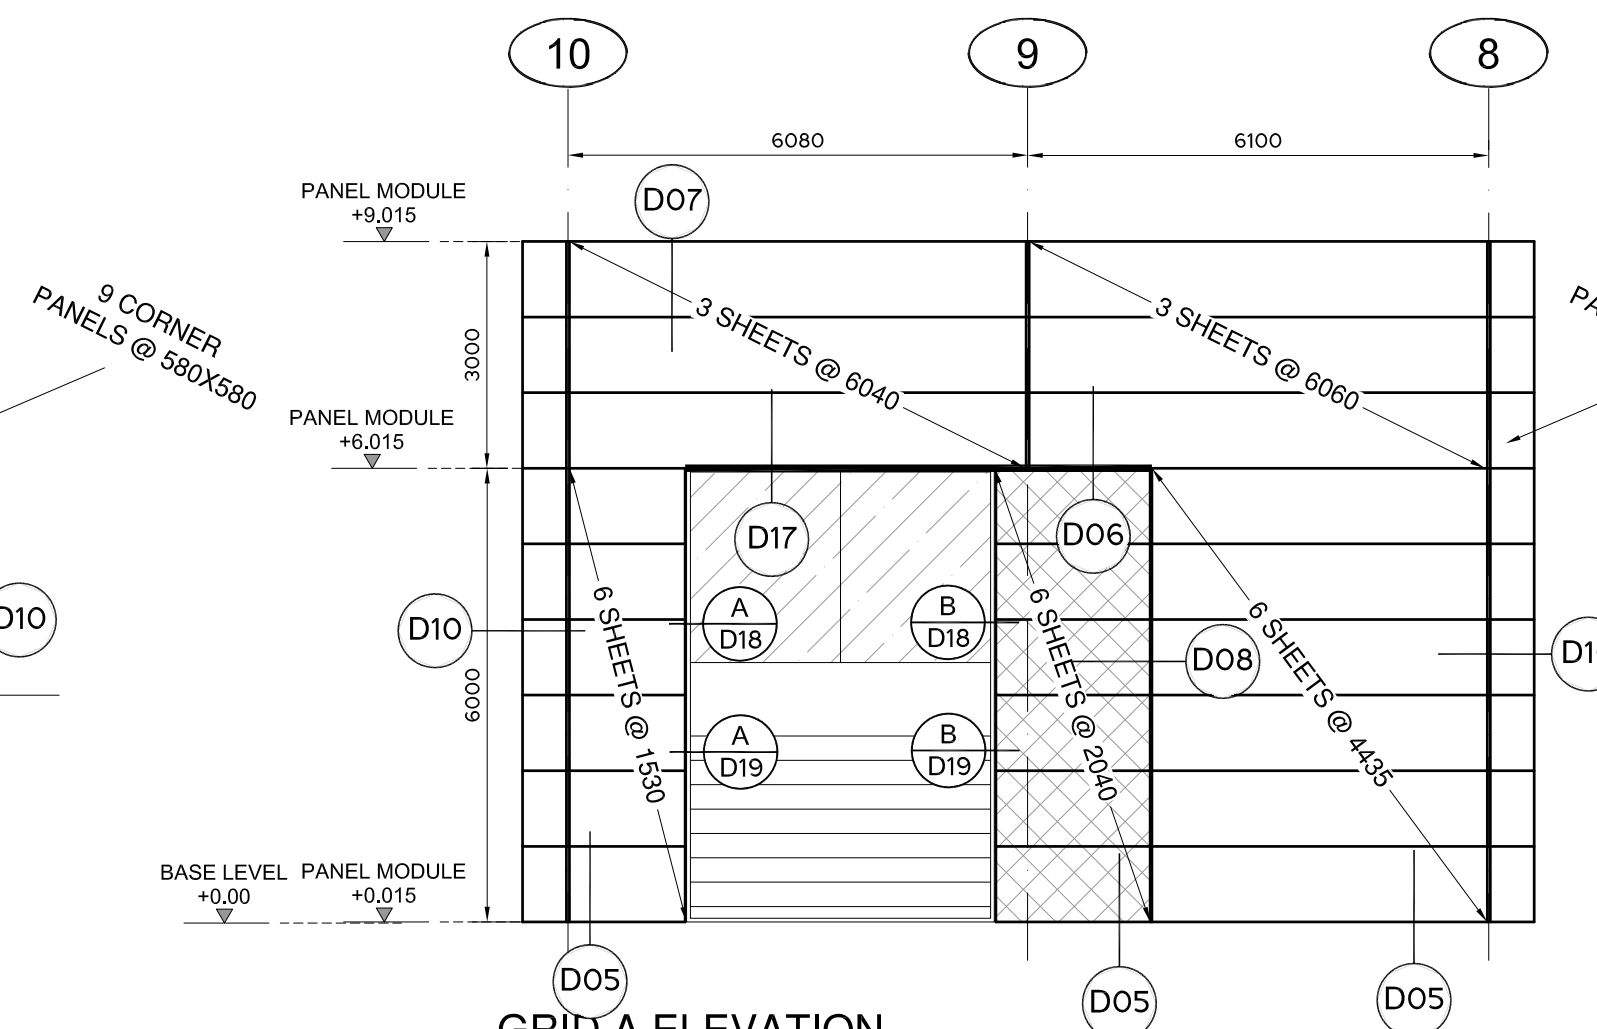


GRID A ELEVATION

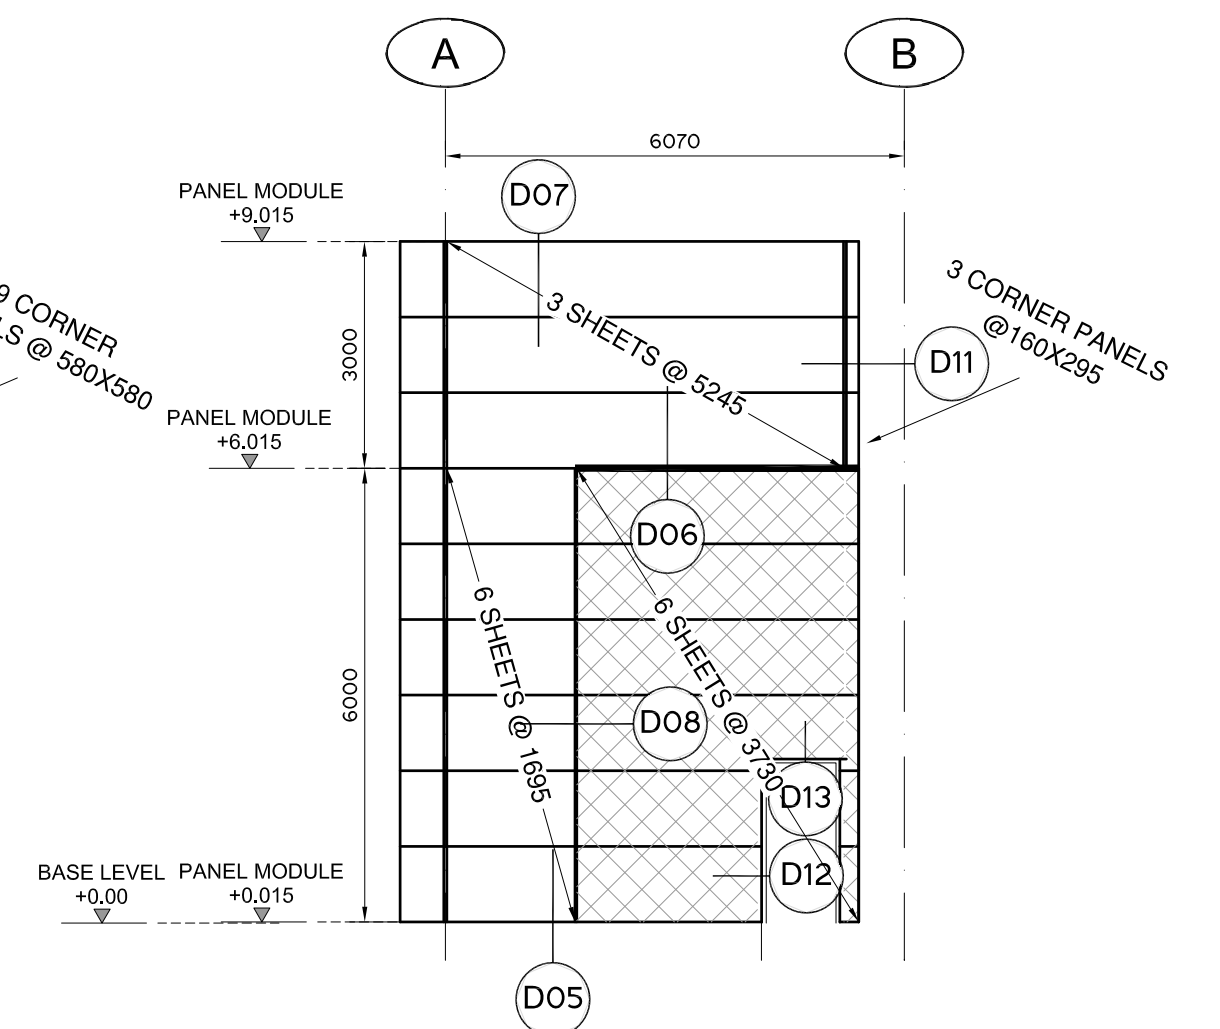


GRID 8 ELEVATION

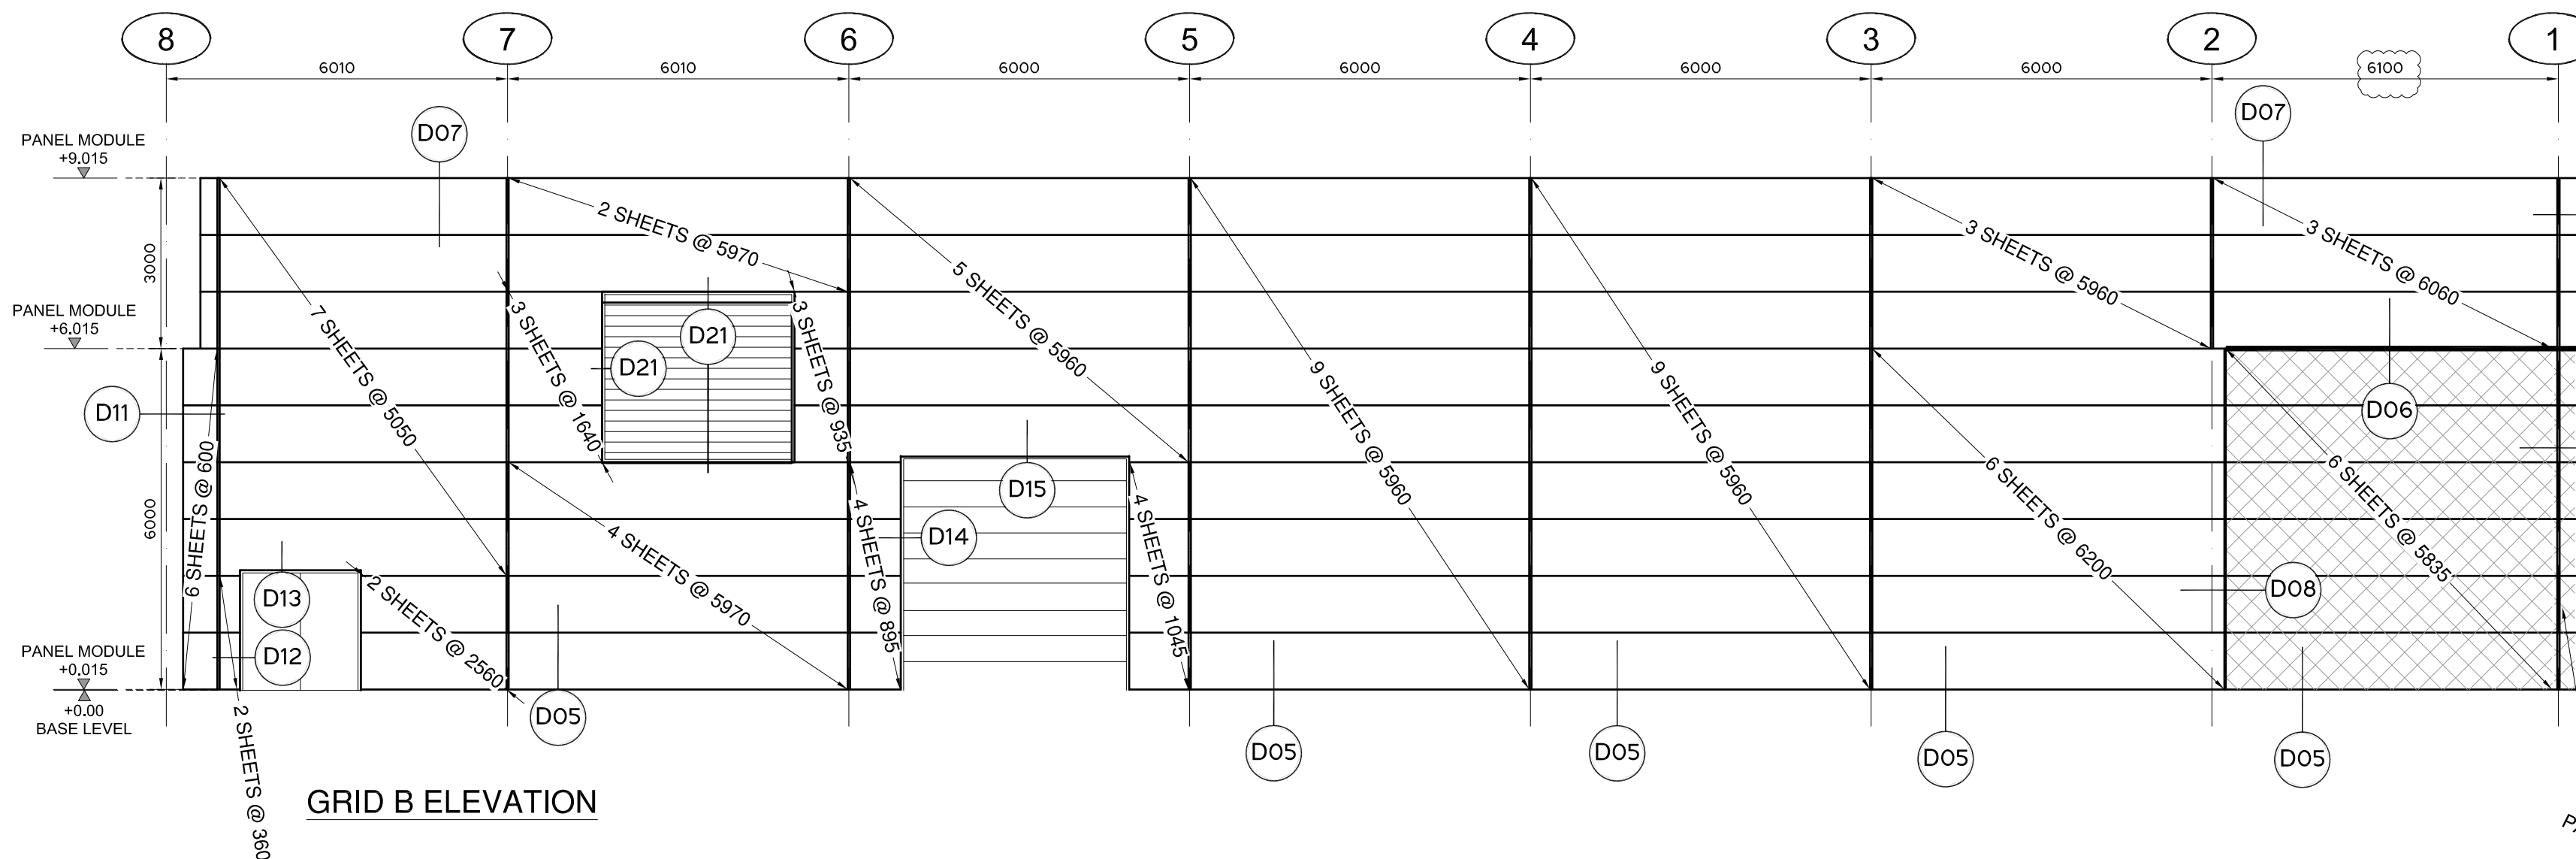

GRID B ELEVATION

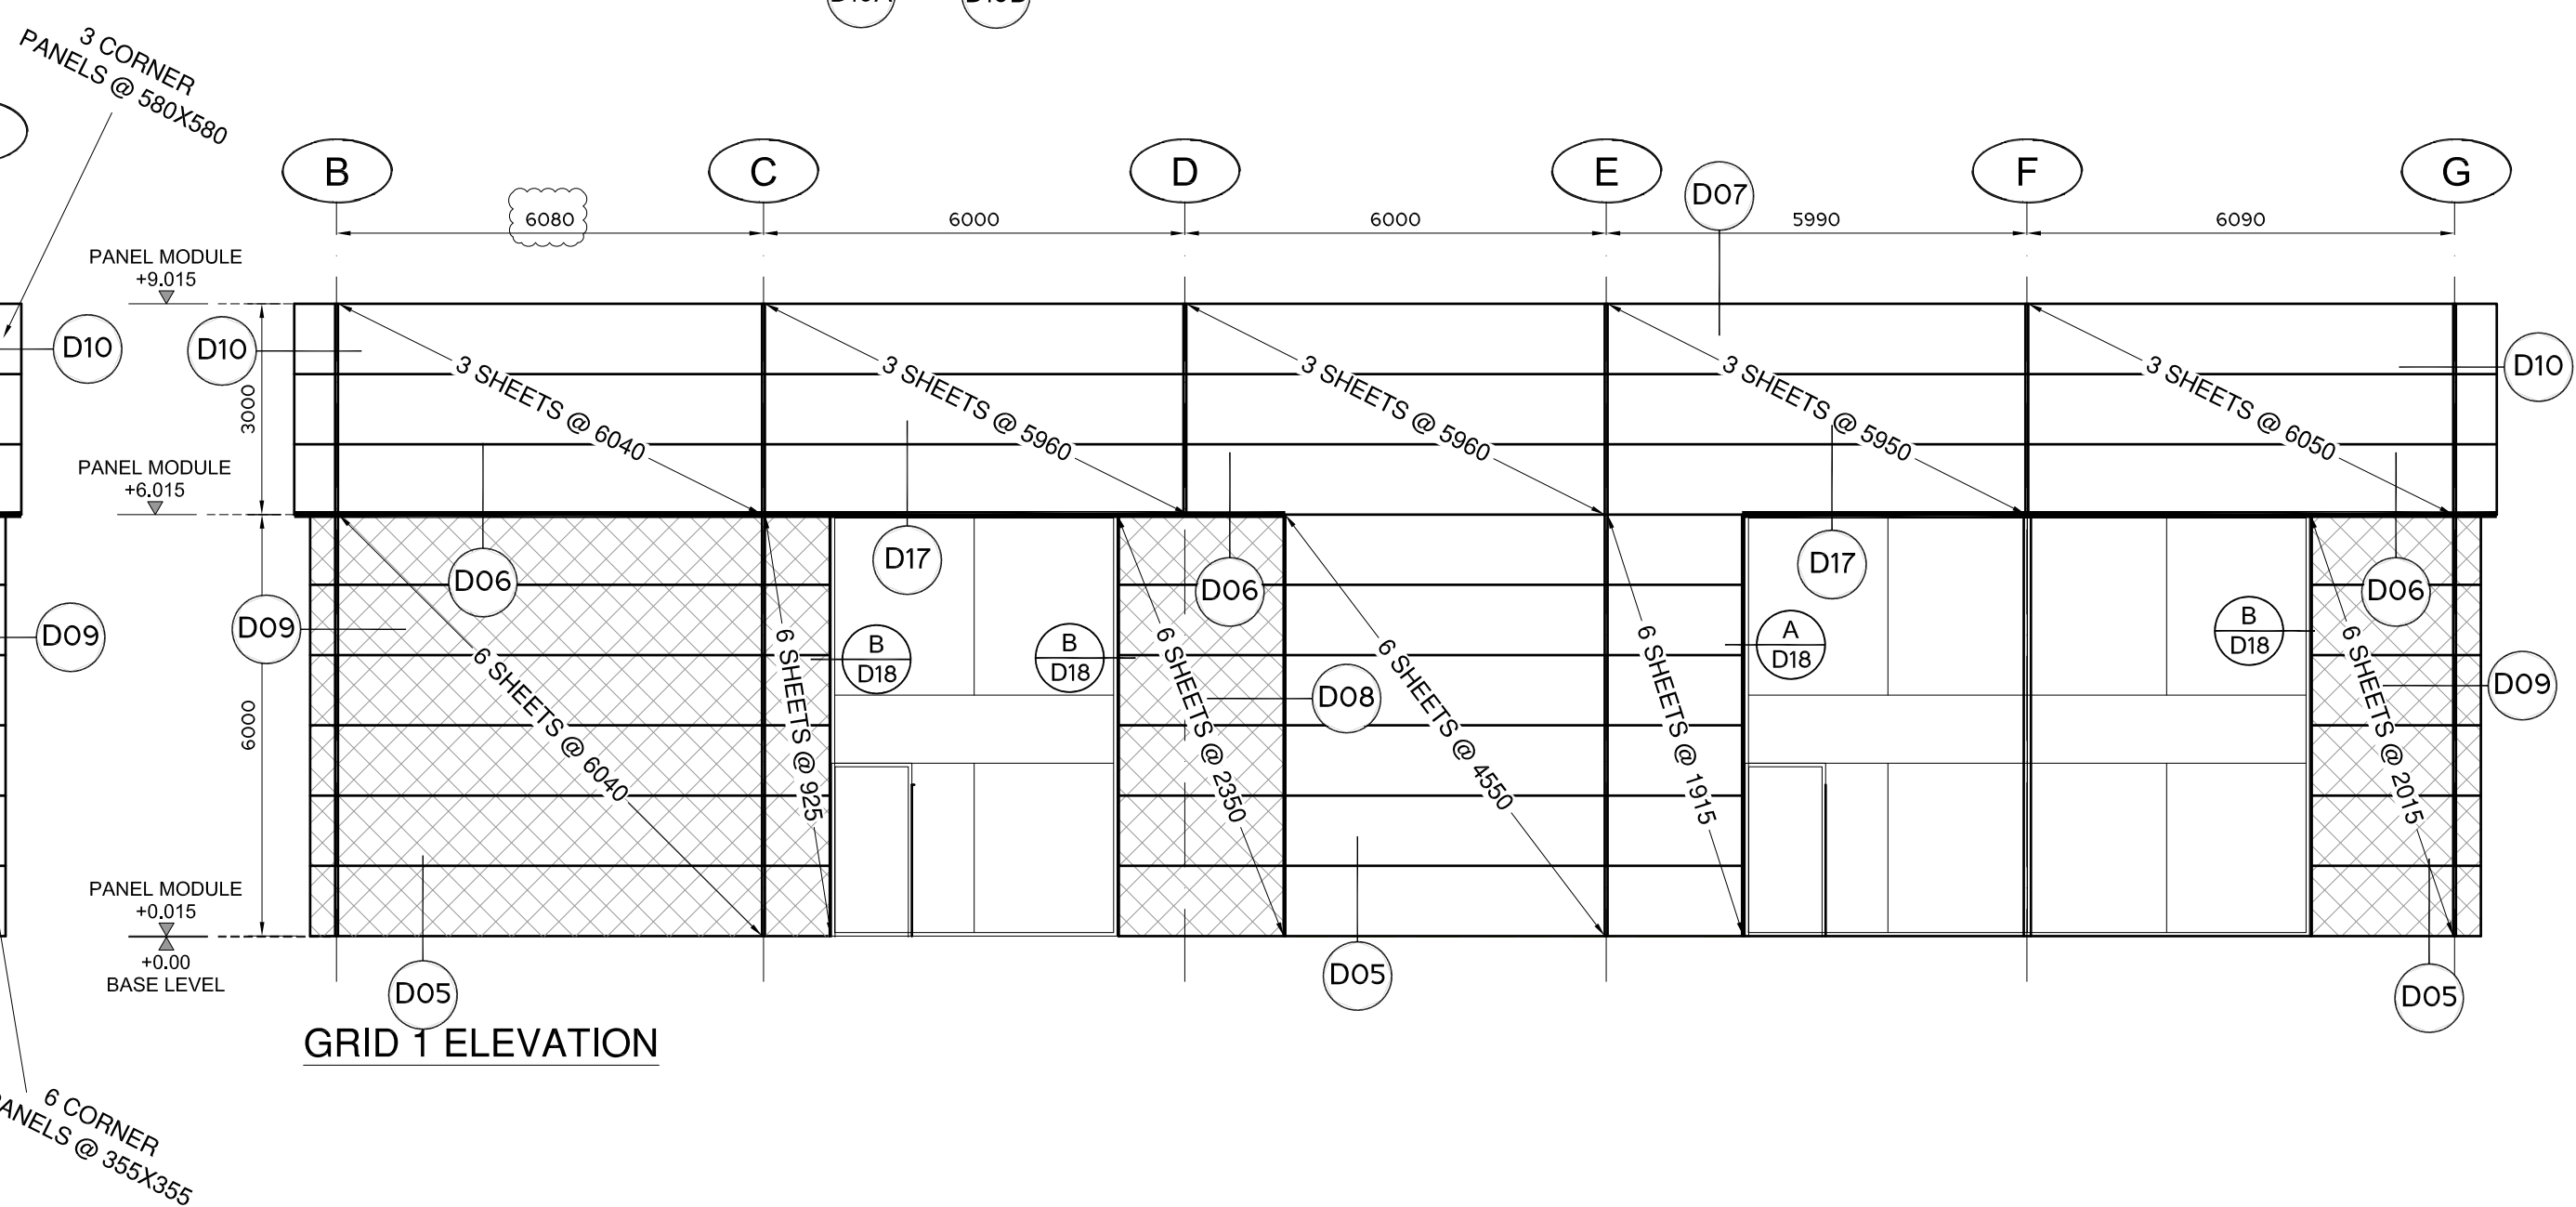

GRID 1 ELEVATION

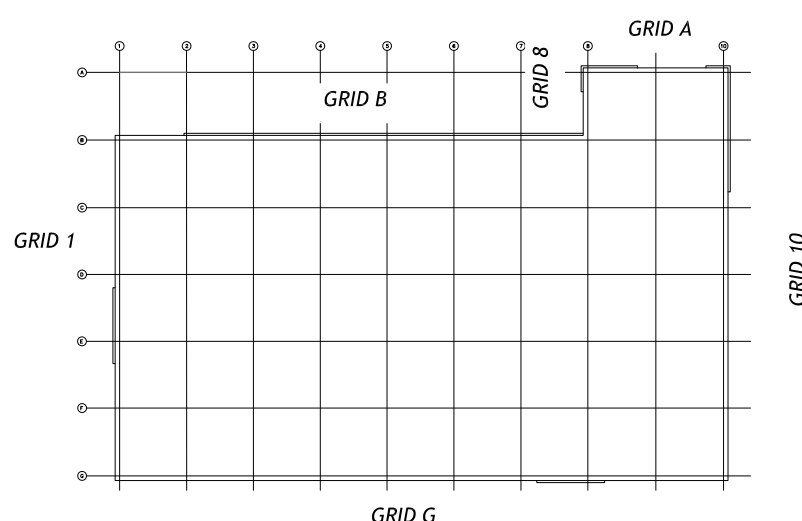

RAL9006 - METALLIC SILVER
80mm THK OPTIMO KINGSPAN
PANEL

RAL9007 - OBSIDIAN
80mm THK OPTIMO
KINGSPAN PANEL

				DRAWN BY: RR	PROJECT TITLE: VW HEDGE END	STATUS: AS BUILT	
				SCALE @ A1: 1:100	DRAWING TITLE: CLADDING ELEVATIONS	REV: AB	DRAWING NO: L02
	AB-ISSUED AS BUILT - 18 MAY 24		AL RR				
	P3 - INTERNAL CORNER PANELS REVISED - 13 MAR 15		RR RF				
	P2 - REVISED TO COMMENTS - 6 MAR 15		RR RF				
	P1-ISSUED FOR APPROVAL - 24 FEB 14		RR RF				
REVISION / AUTHOR / CHECKER							