




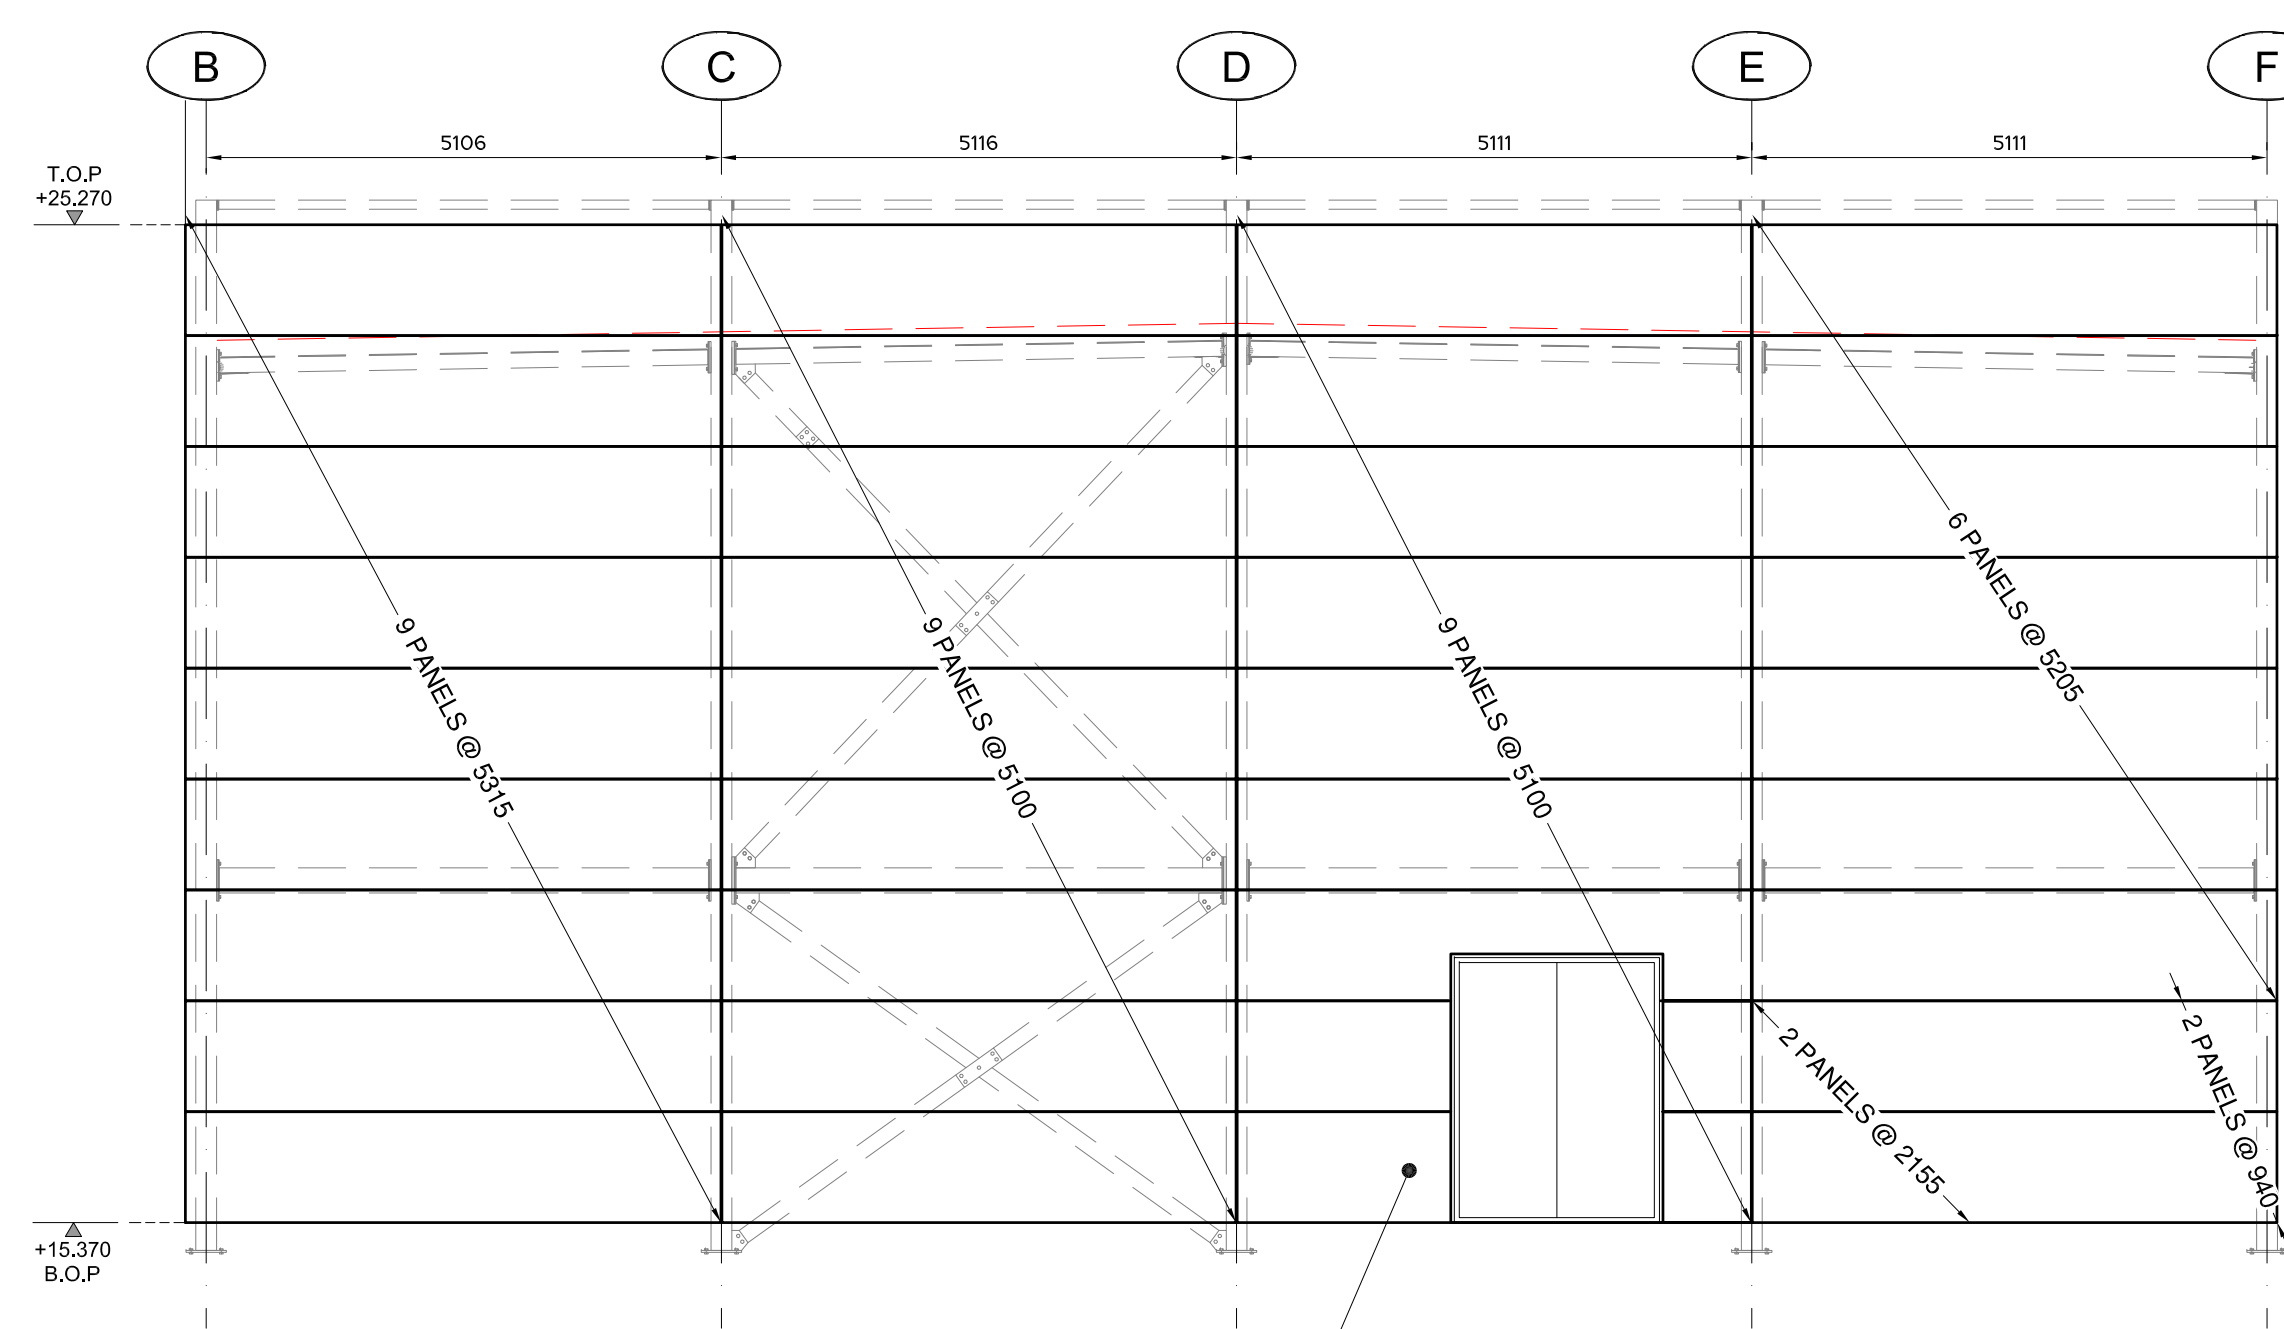


ELEVATION ON GRIDLINE 11

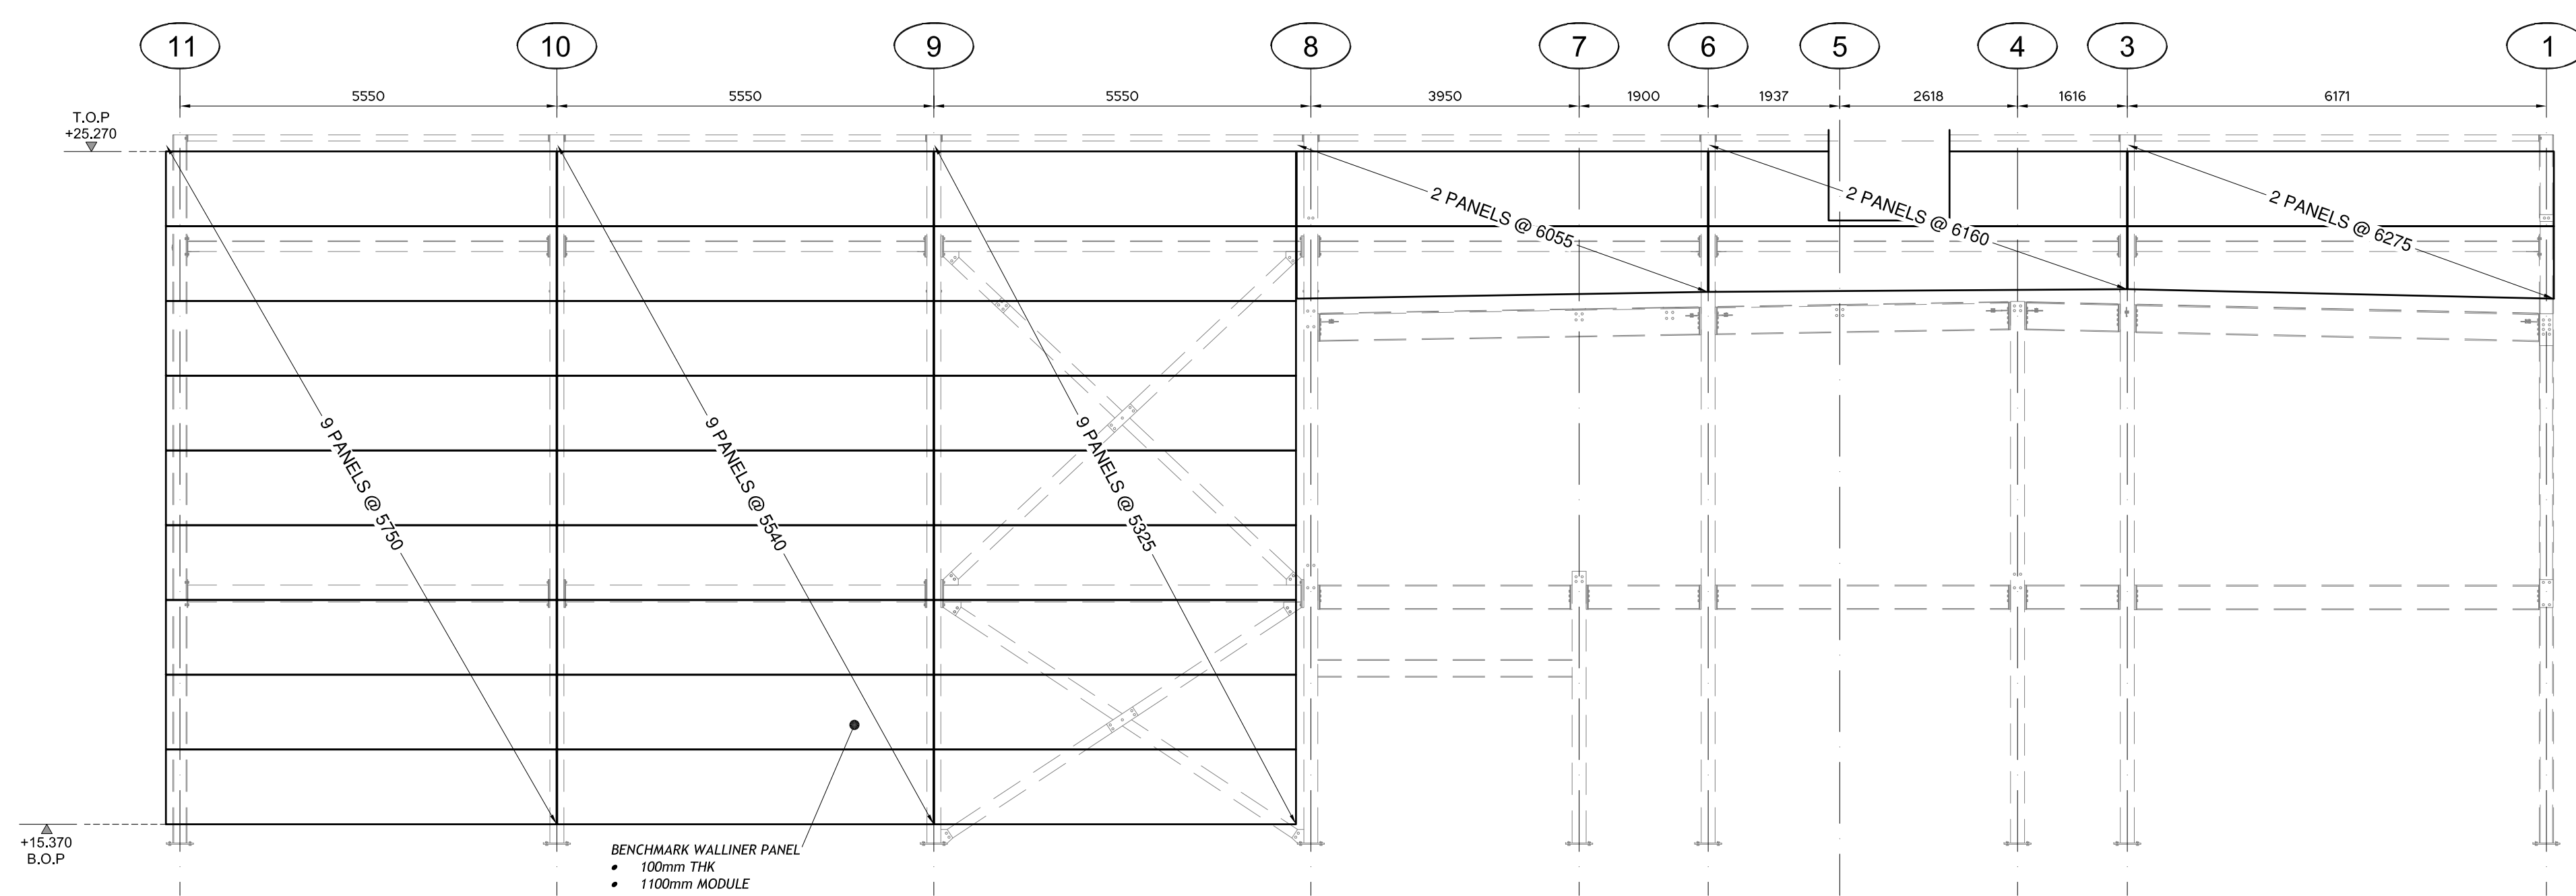


ELEVATION ON GRIDLINE F

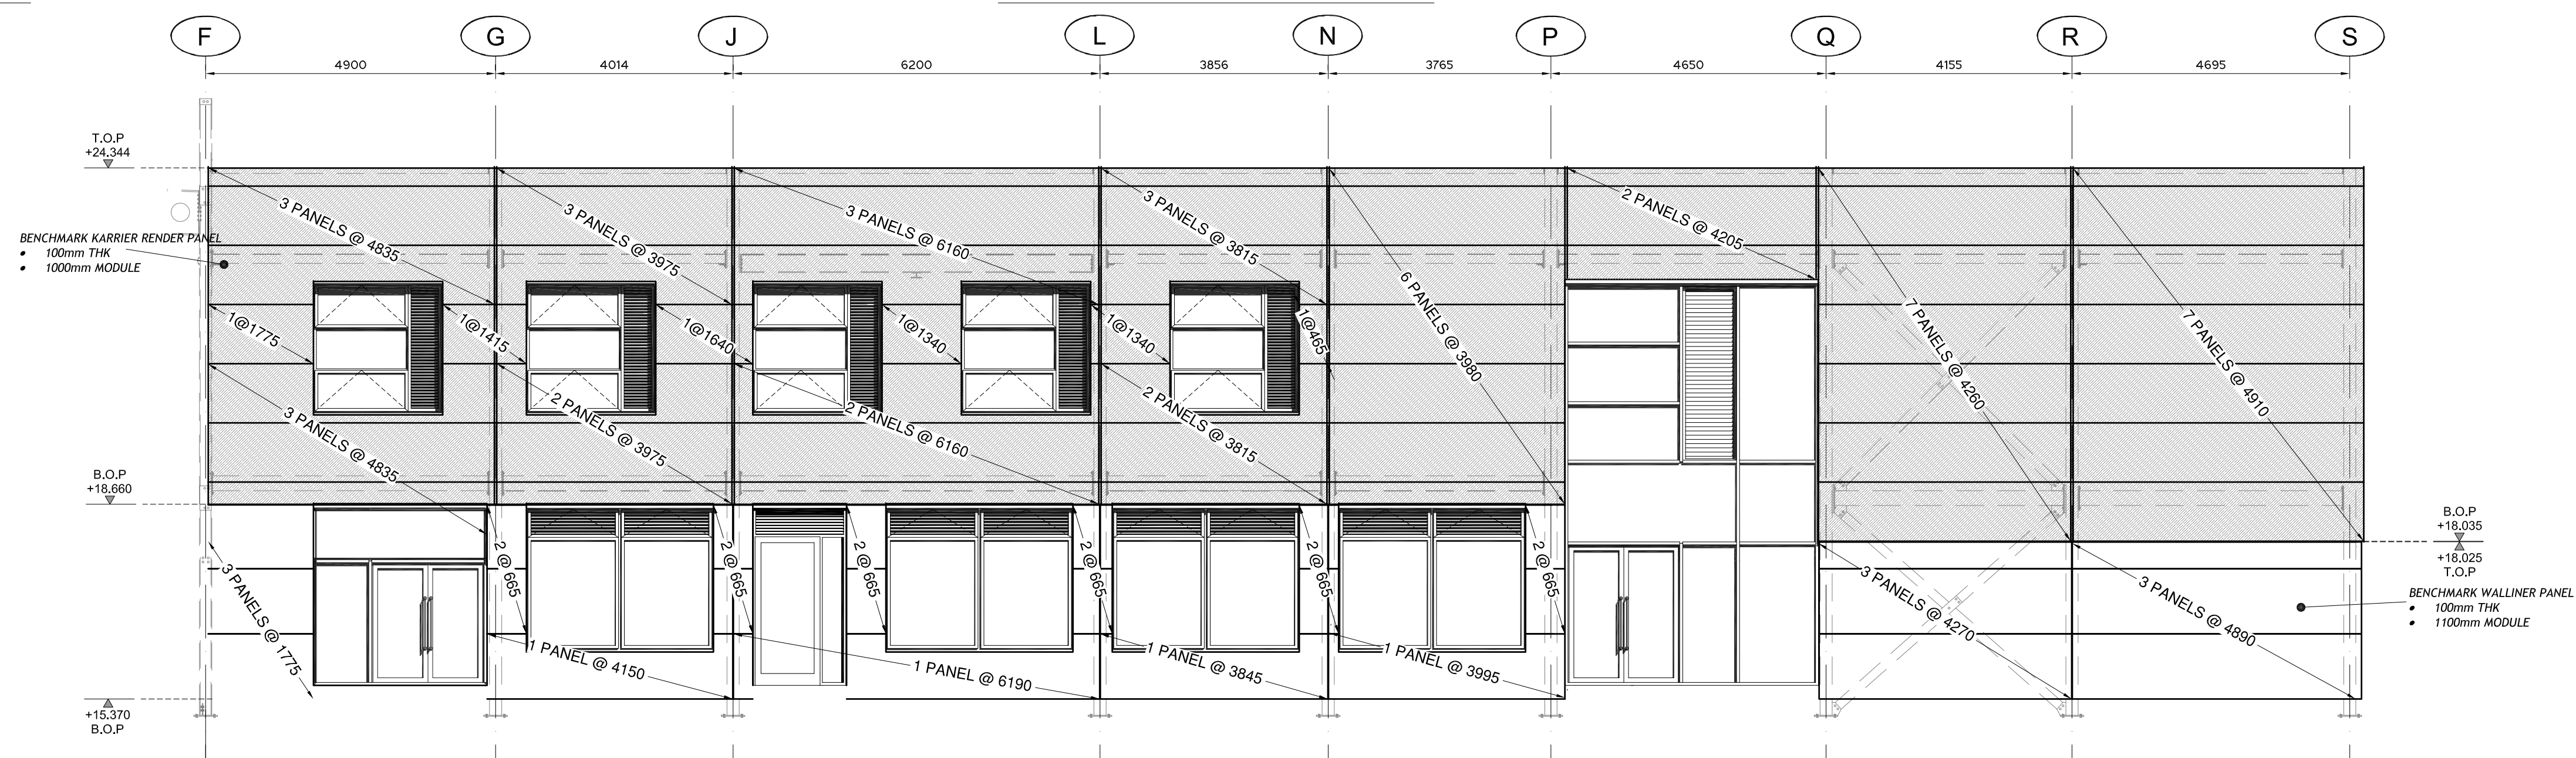

ELEVATION ON GRIDLINE 8

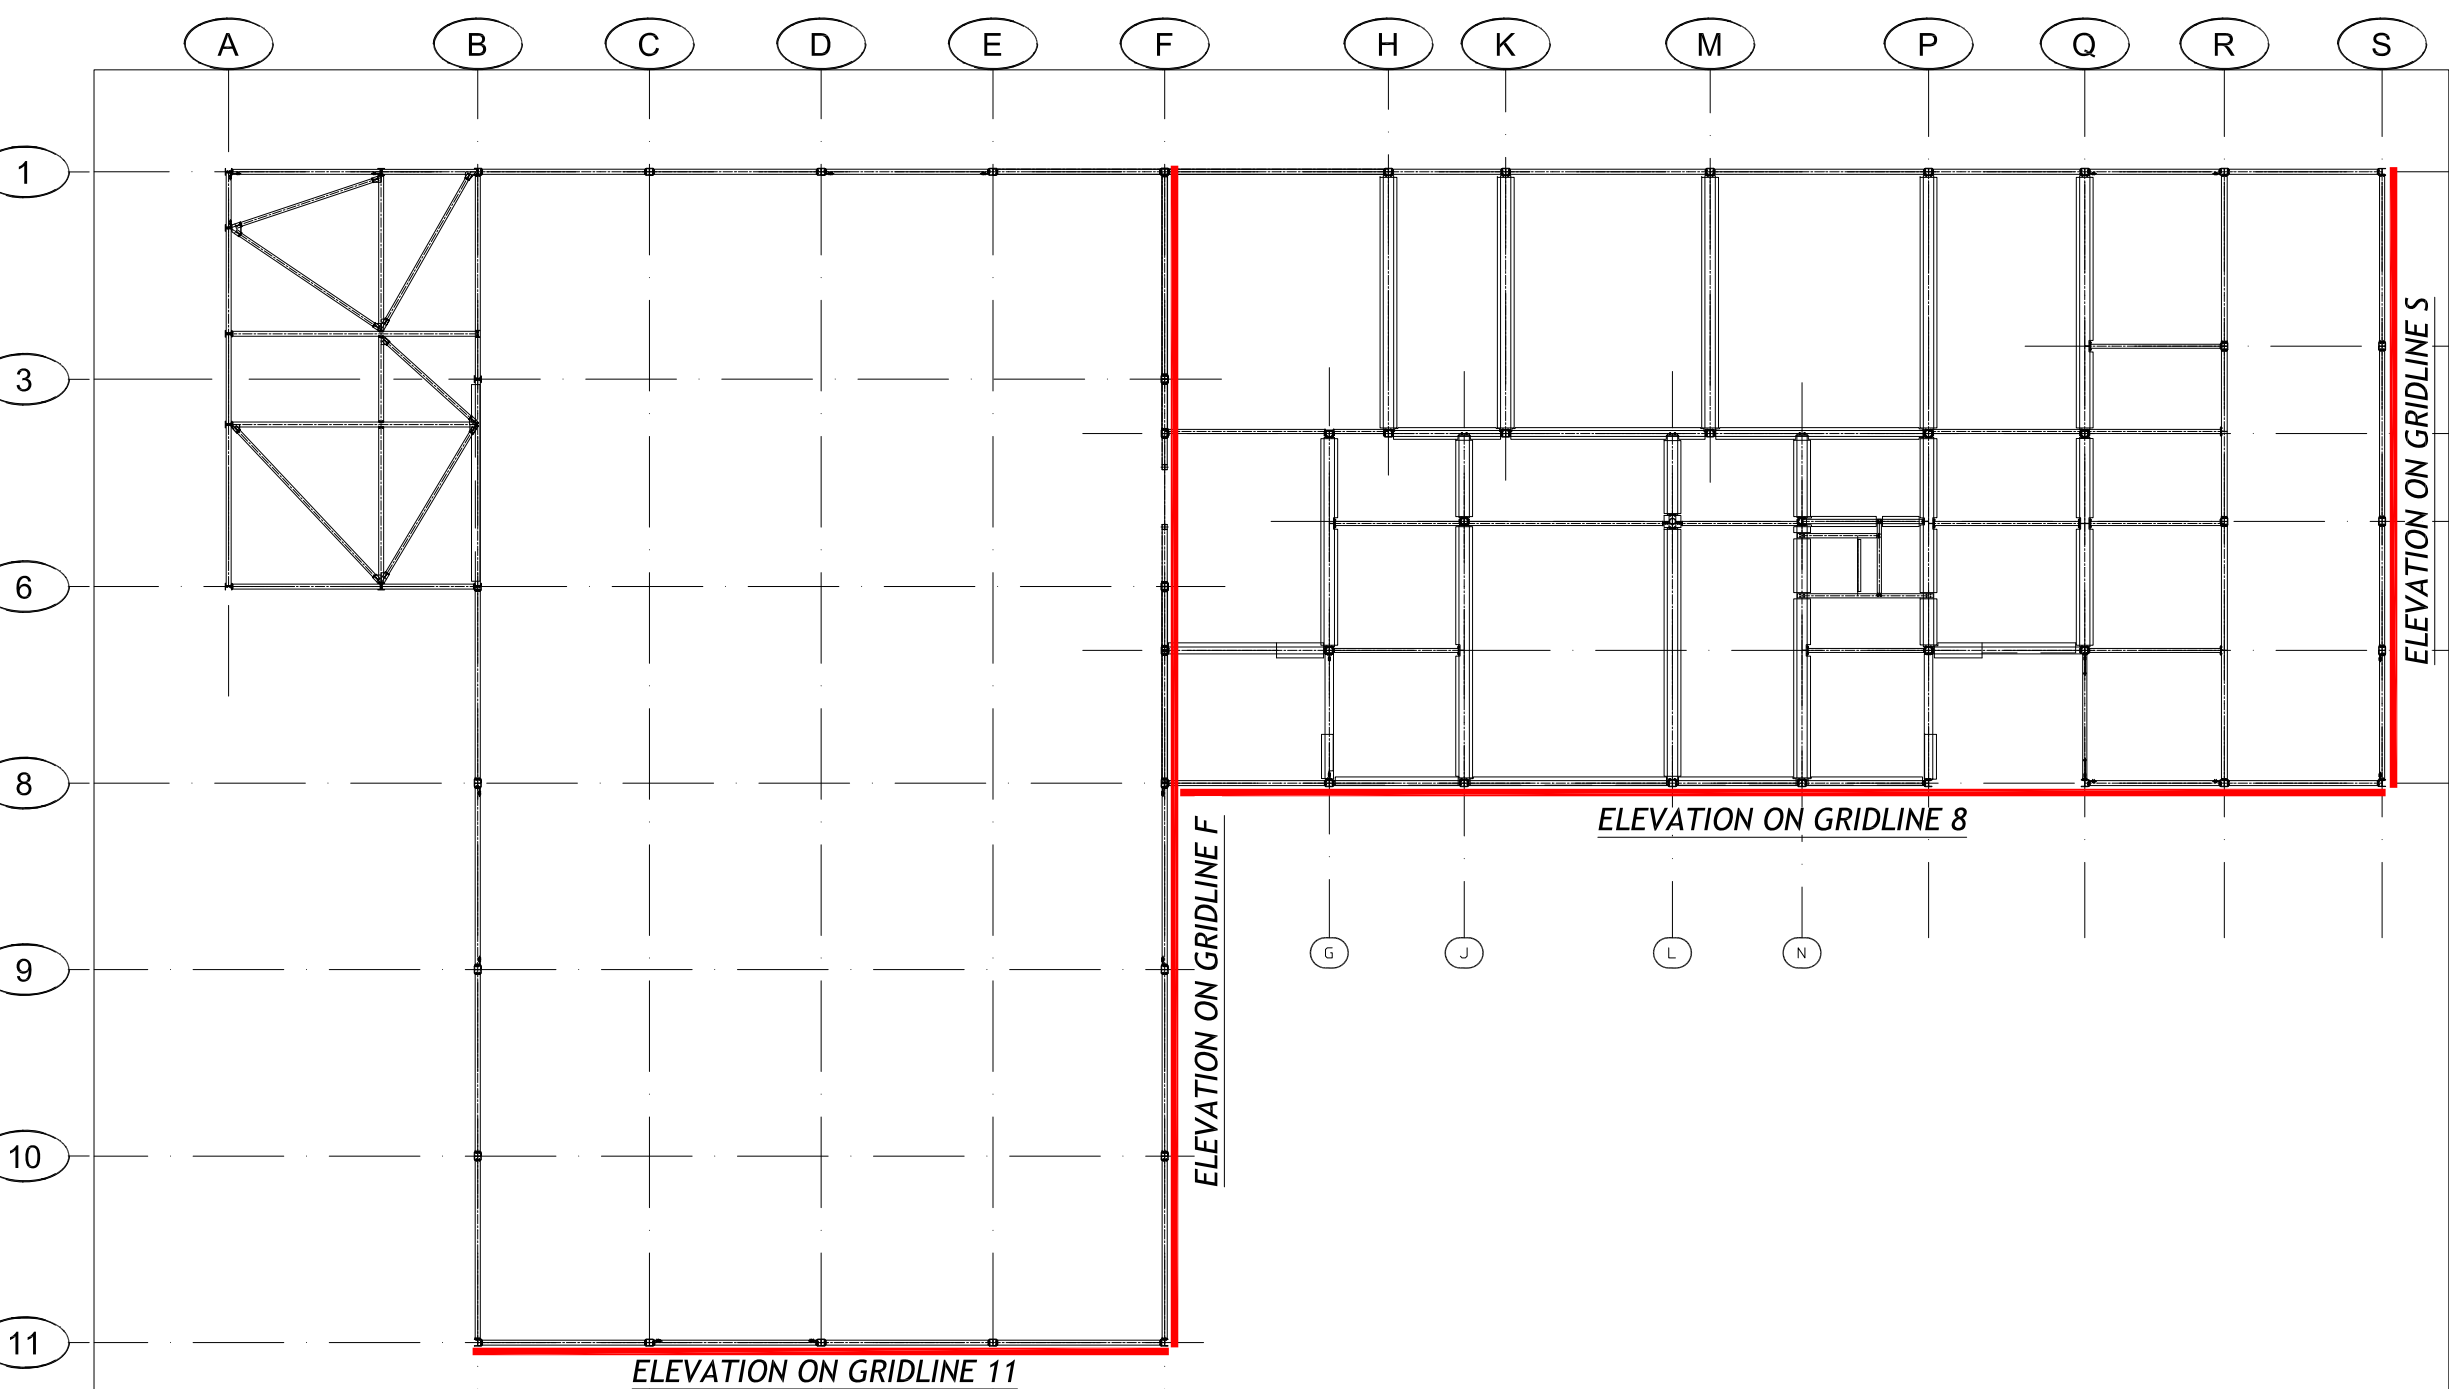

KEY PLAN
SCALE 1:225

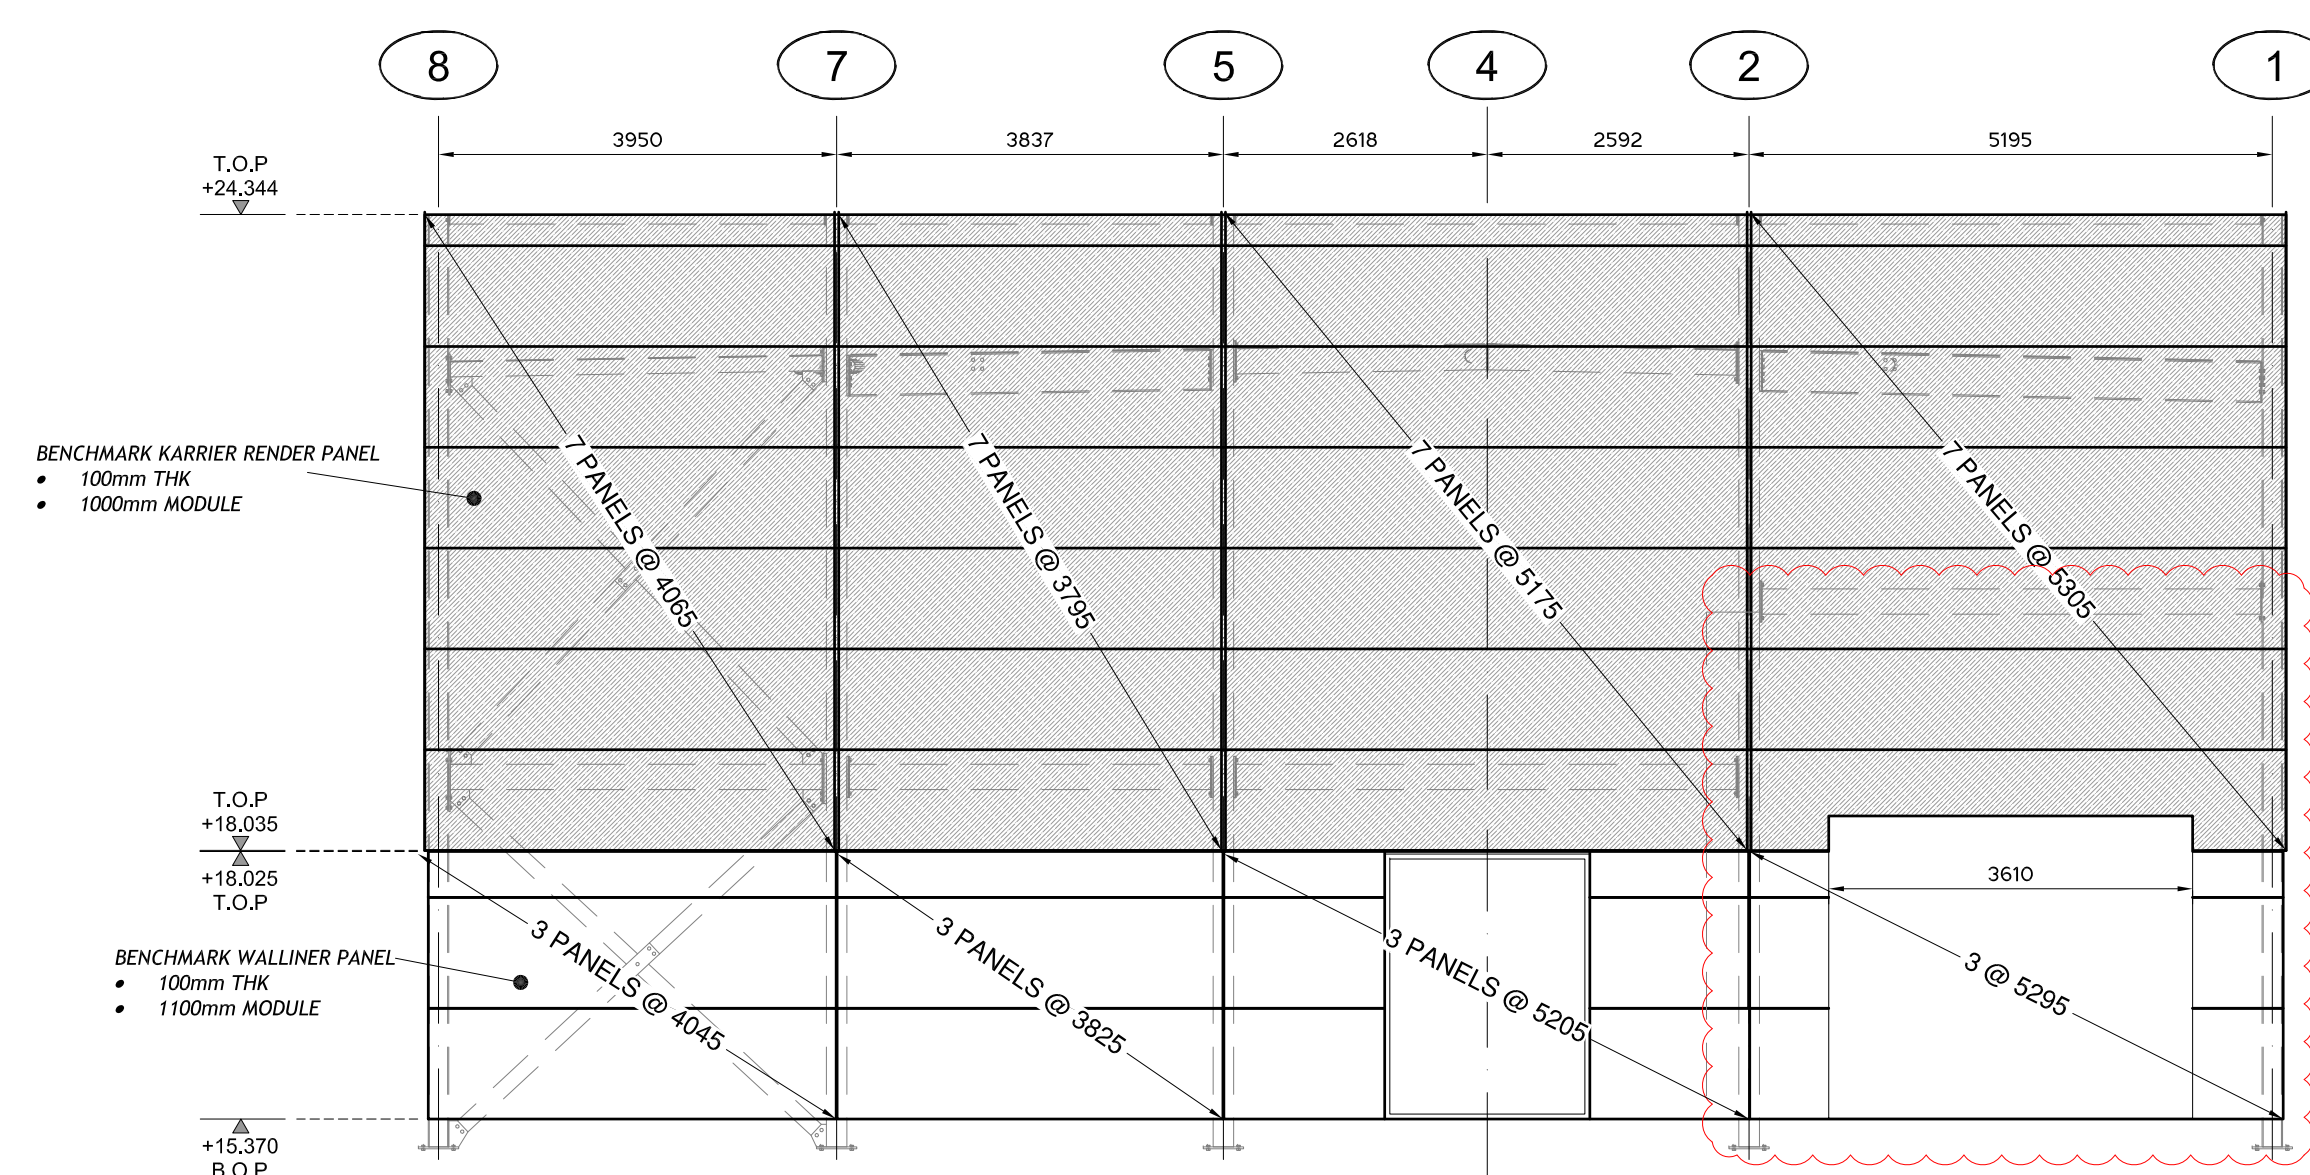

ELEVATION ON GRIDLINE S

NOTE: AREA IN ABEYANCE

NOTE: PANEL LENGTHS AROUND
OPENINGS BASED ON ARCHITECTS SETTING
OUT DWG NO: BCA-BBA-Z0-GF-DR-A-02101,
BCA-BBA-Z0-GF-DR-A-02102

REVISION / AUTHOR / CHECKER	AS-ISSUED AS BUILT - 19 May 16	RF	RF	DRAWN BY: AL	PROJECT TITLE: THOMAS KNYVETT / BROOKLANDS COLLEGE	STATUS: AS BUILT	
	C1 - CONSTRUCTION ISSUE - 08 MAR 16	RR	RF				
	P4- RENDER PANELS ADJUSTED - 05 FEB 16	RR	RF				
	P3- REVISED TO CHANGES - 04 FEB 16	RR	RF				
	P2- REVISED TO SPEC CHANGES - 02 FEB 16	RR	RF				
REVISION / AUTHOR / CHECKER	P1- ISSUED FOR APPROVAL - 20 JAN 16	AL	RR	SCALE @ A1: 1:75	DRAWING TITLE: KARRIER PANEL ELEVATIONS ON GRIDLINE F,8 & S	REV: AB	DRAWING NO: L06