




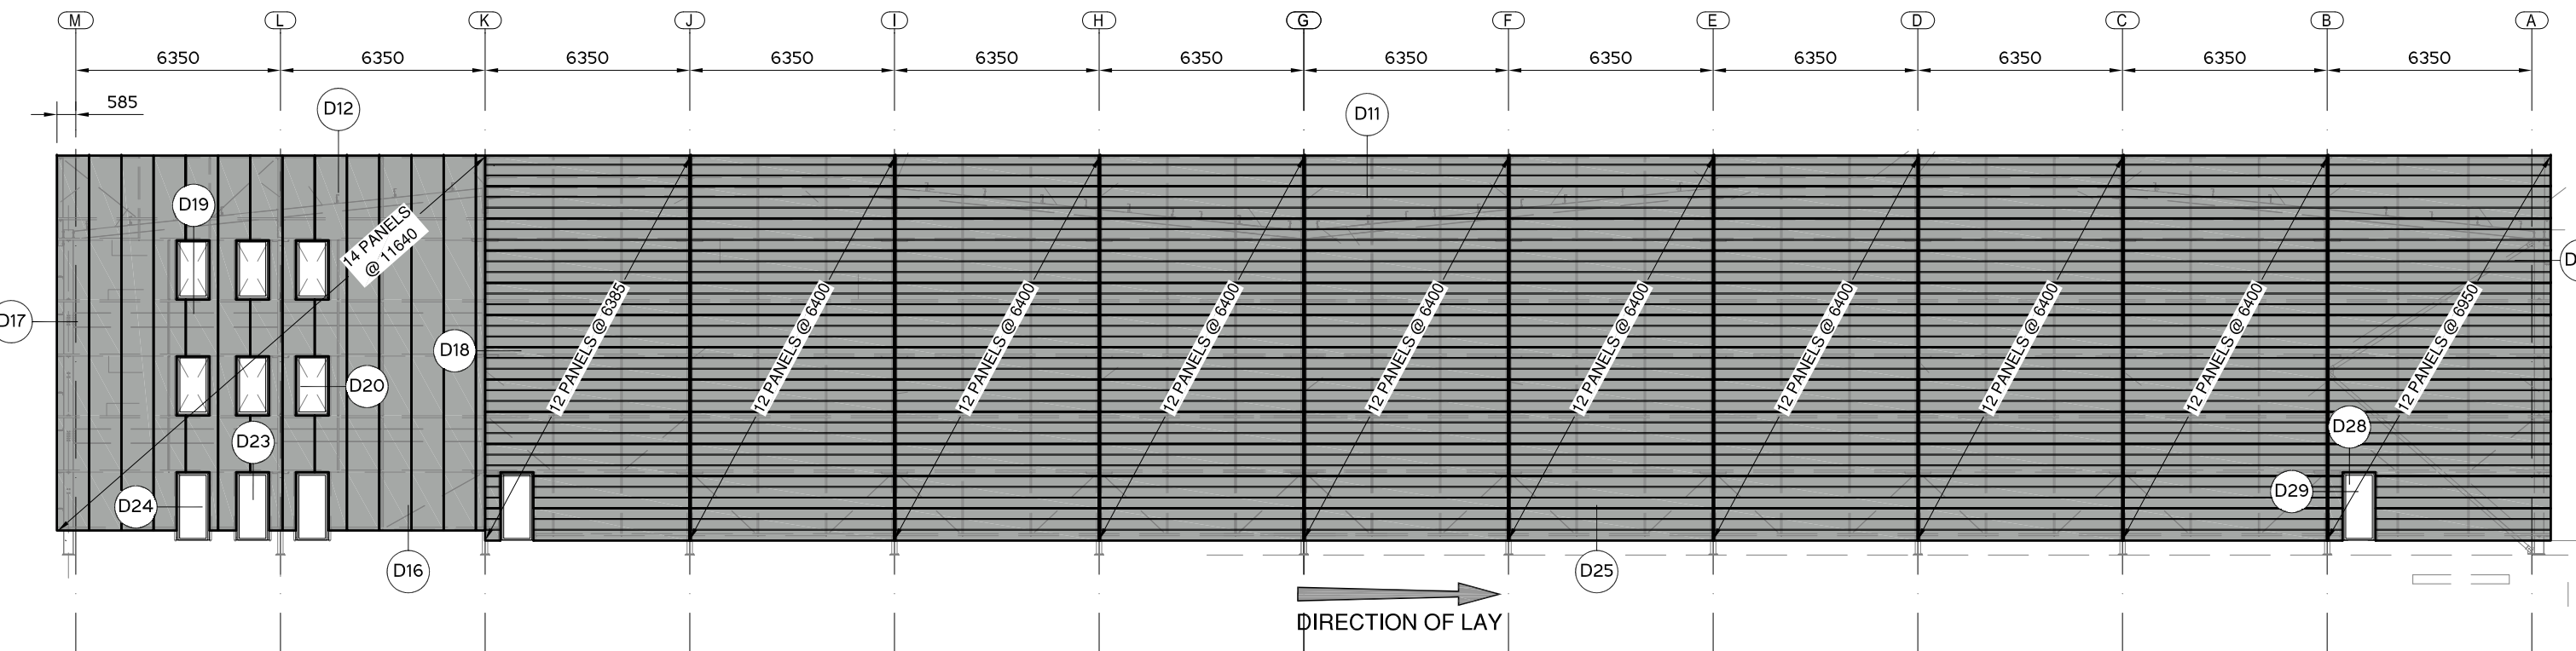

ELEVATION GRID 20

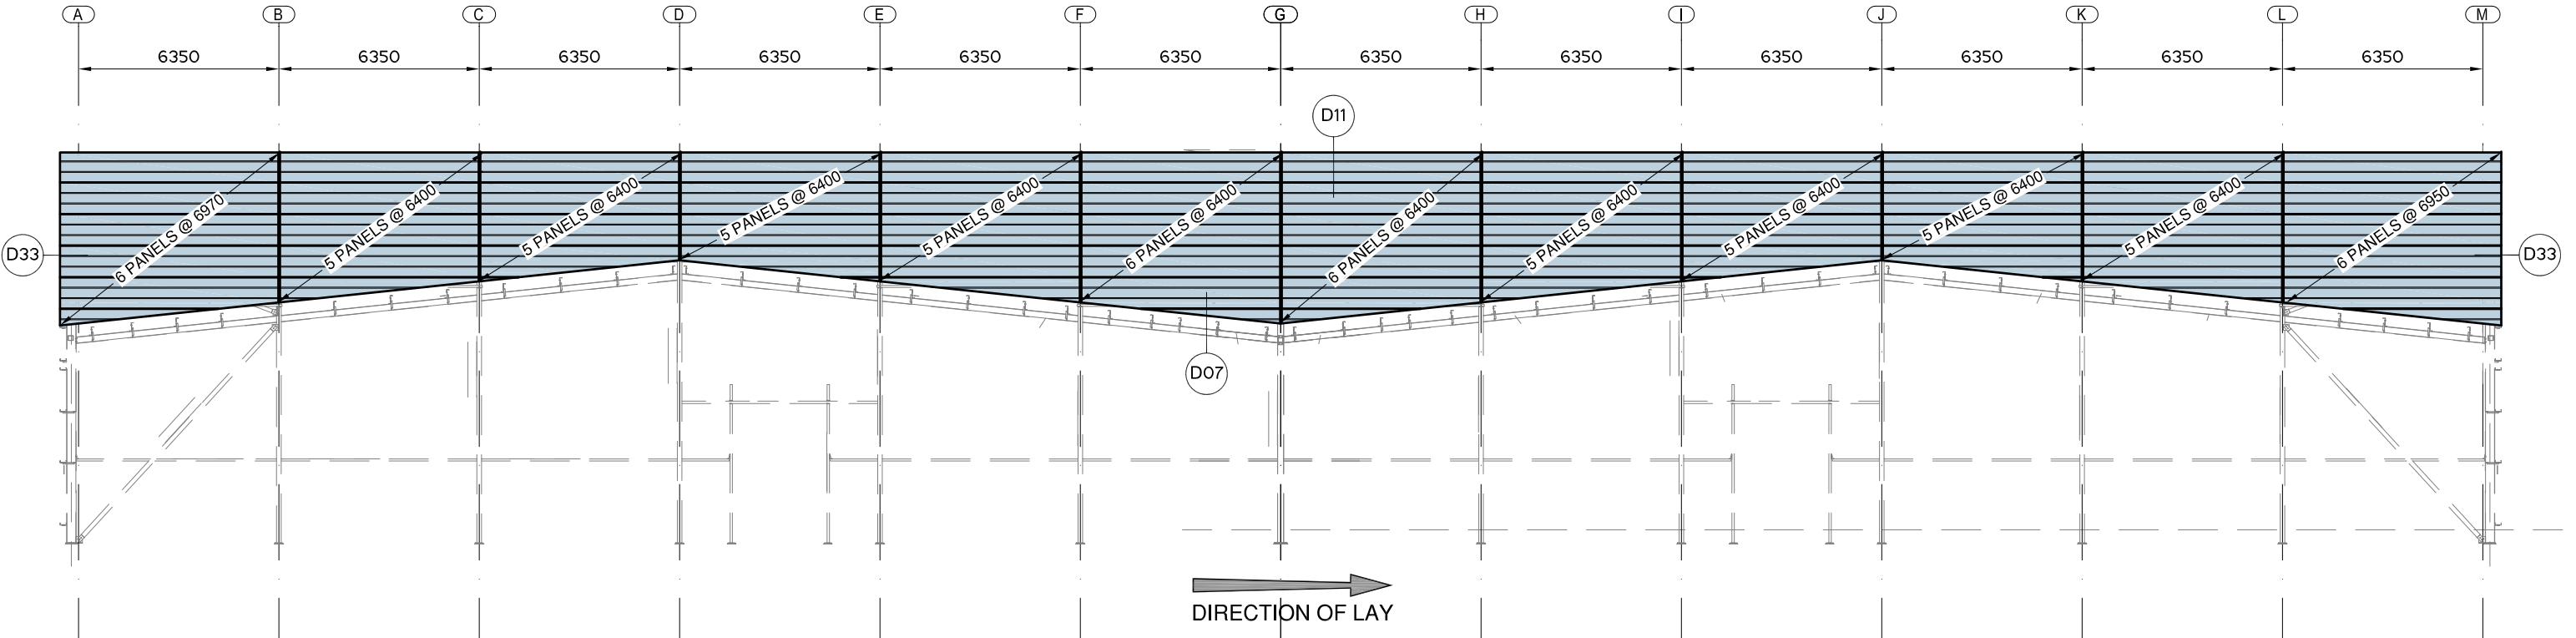


ELEVATION GRID 8

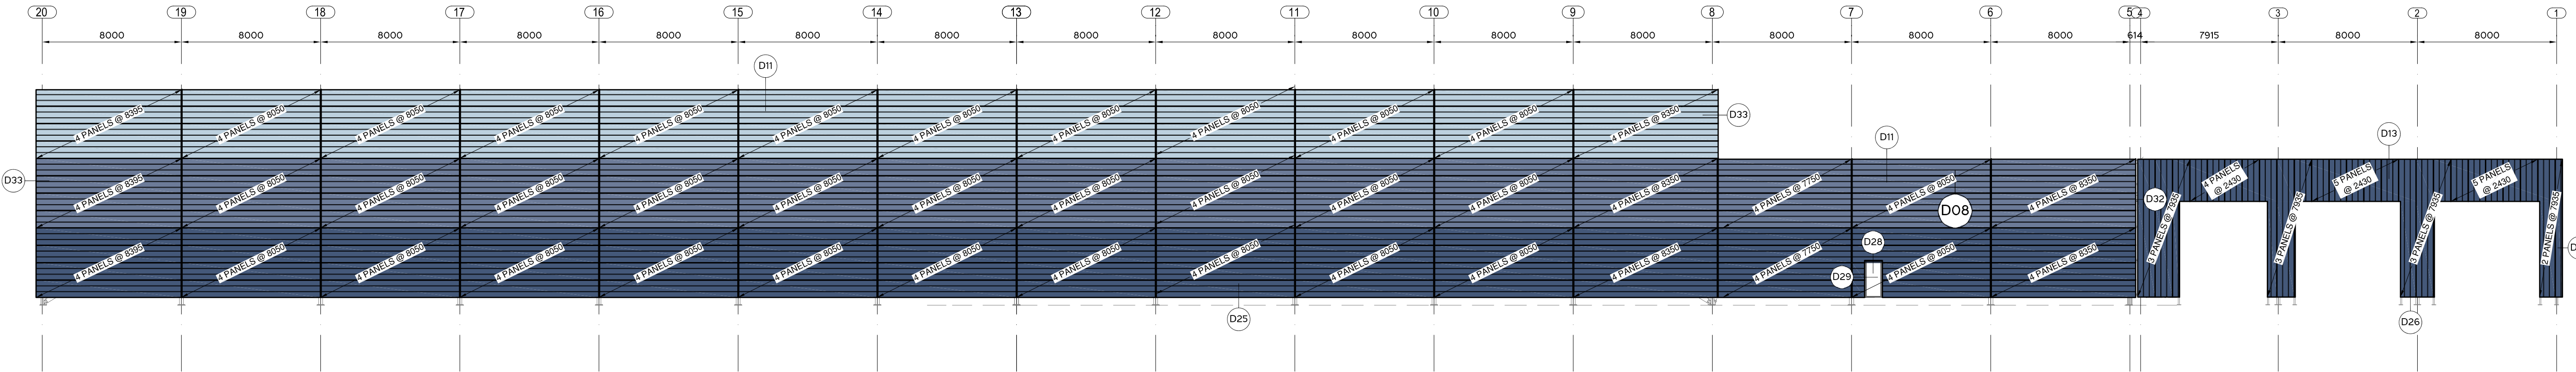


ELEVATION GRID A

ELEVATION GRID CA

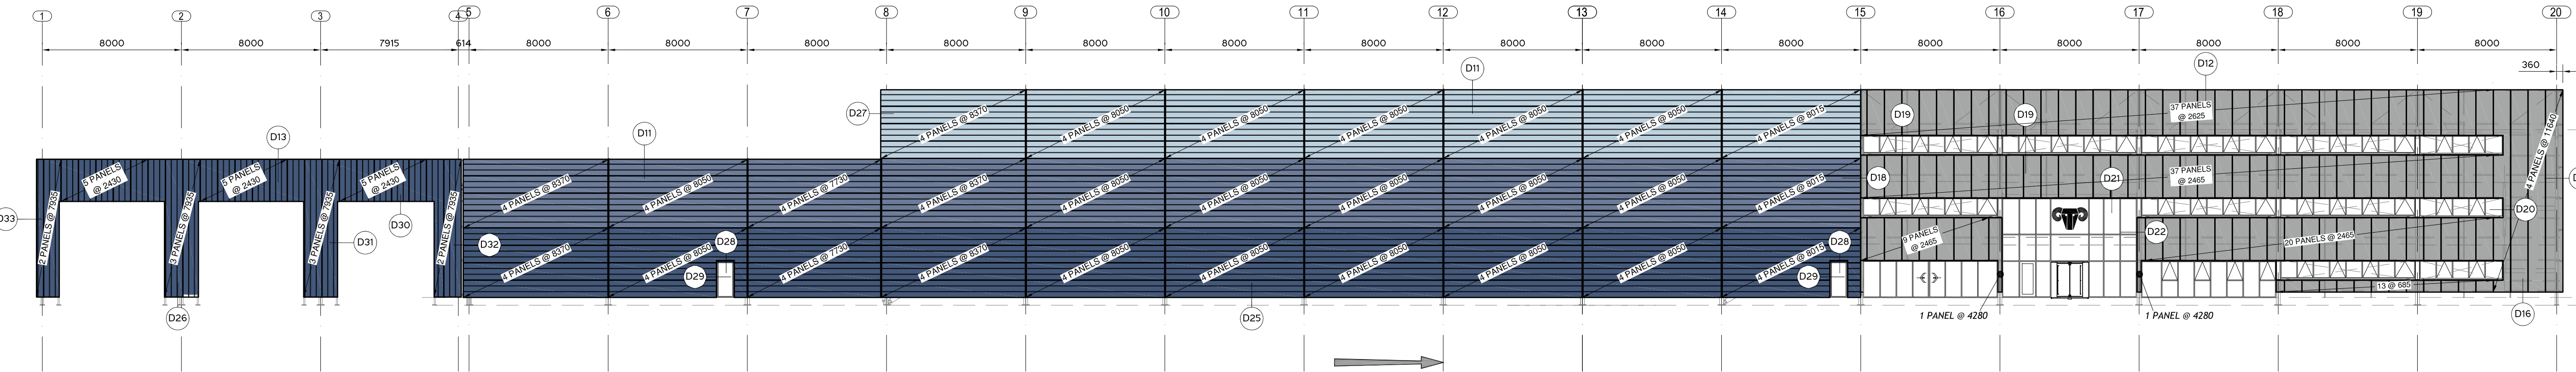


ELEVATION GRID M

ELEVATION GRID FA

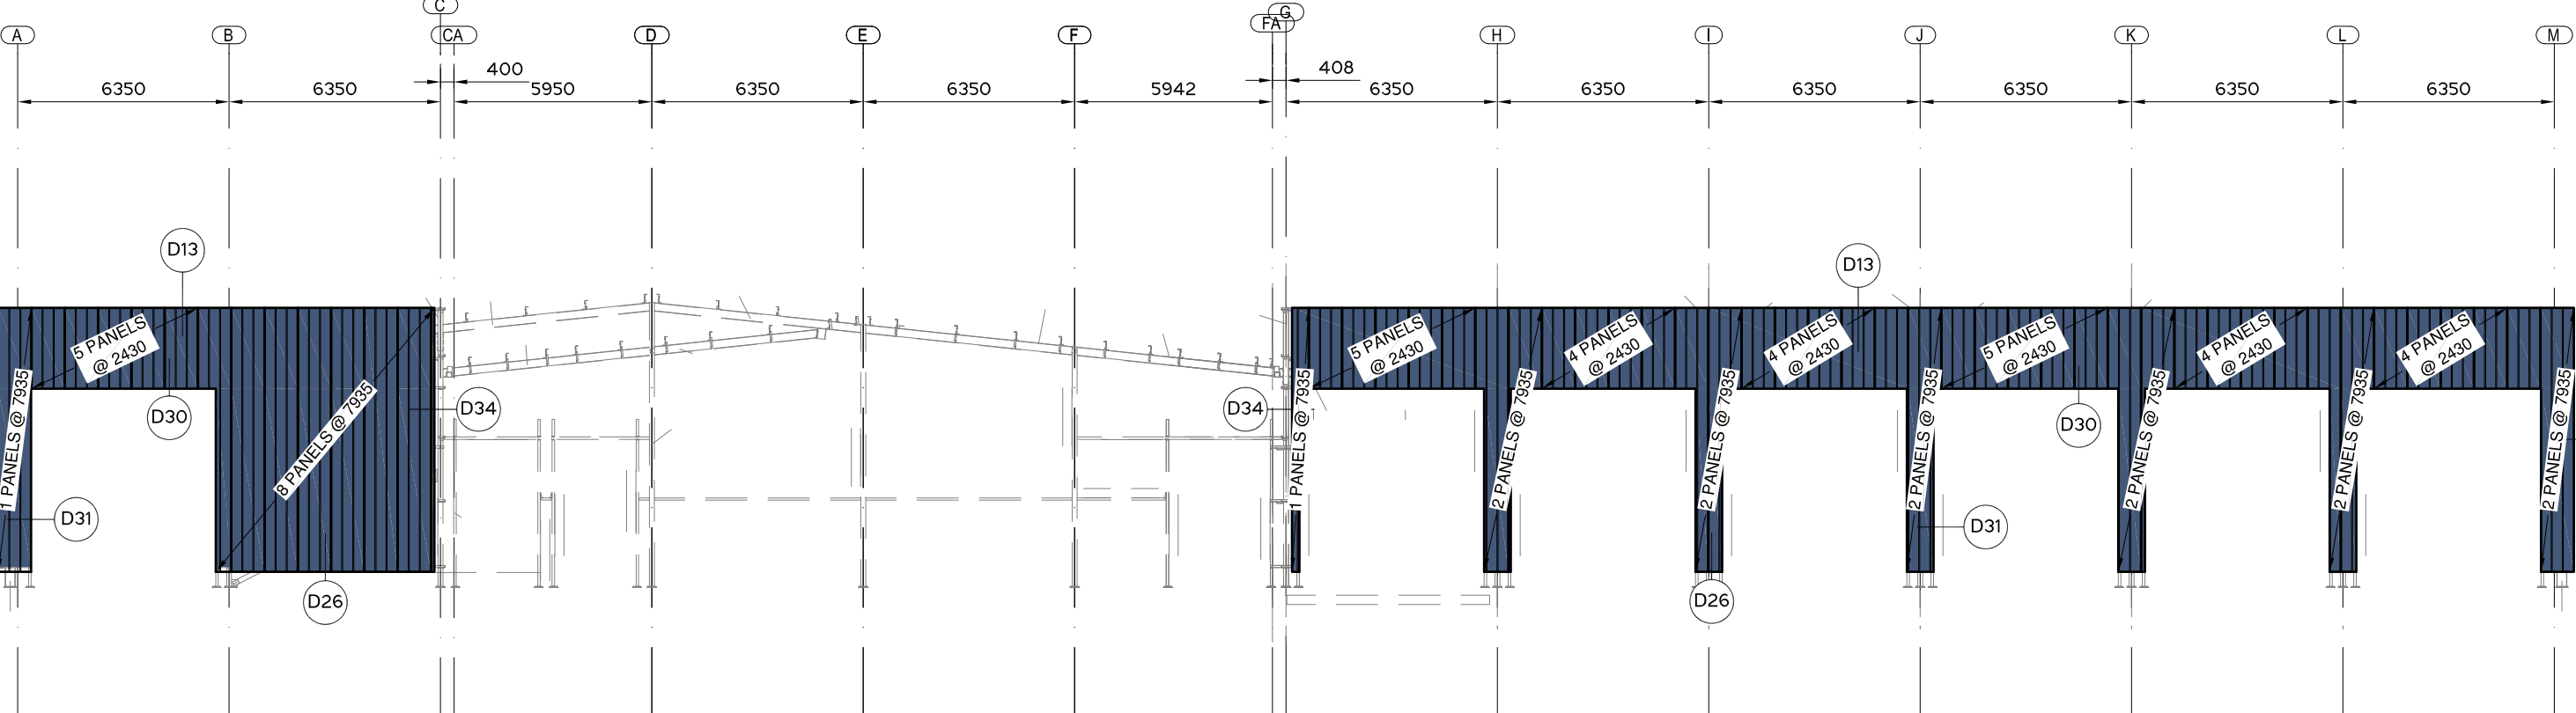

ELEVATION GRID 5

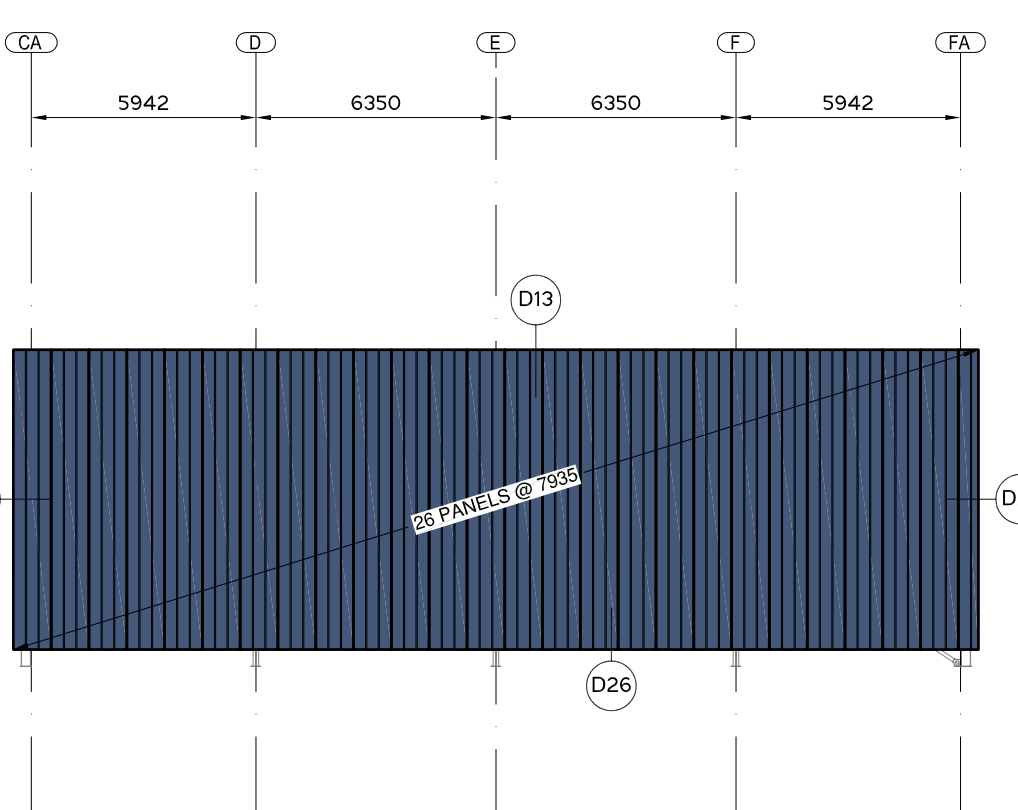

ELEVATION GRID 1

- = METALLIC SILVER RAL 9006
- = PASTEL BLUE RAL 240 80 10
- = DENIM RAL 5014
- = DEEP BLUE RAL 260 40 20

NOTE: ALL PARAPET PANELS TO BE COLOUR PASTEL BLUE RAL 240 80 10

	DRAWN BY: PL	PROJECT TITLE: TRILANCO LTD	STATUS: AS BUILT	
	SCALE @ A1: 1:200	DRAWING TITLE: ELEVATIONS	REV: AB	DRAWING NO: 345-L07
	REVISION / AUTHOR / CHECKER			