



WHERE FIXING ALUMINIUM TO ANOTHER MATERIAL A BARRIER TAPE IS TO BE USED
 ALL FIXINGS INTO ALUMINIUM TO BE STAINLESS STEEL


REFER TO DRAWING 276-D02

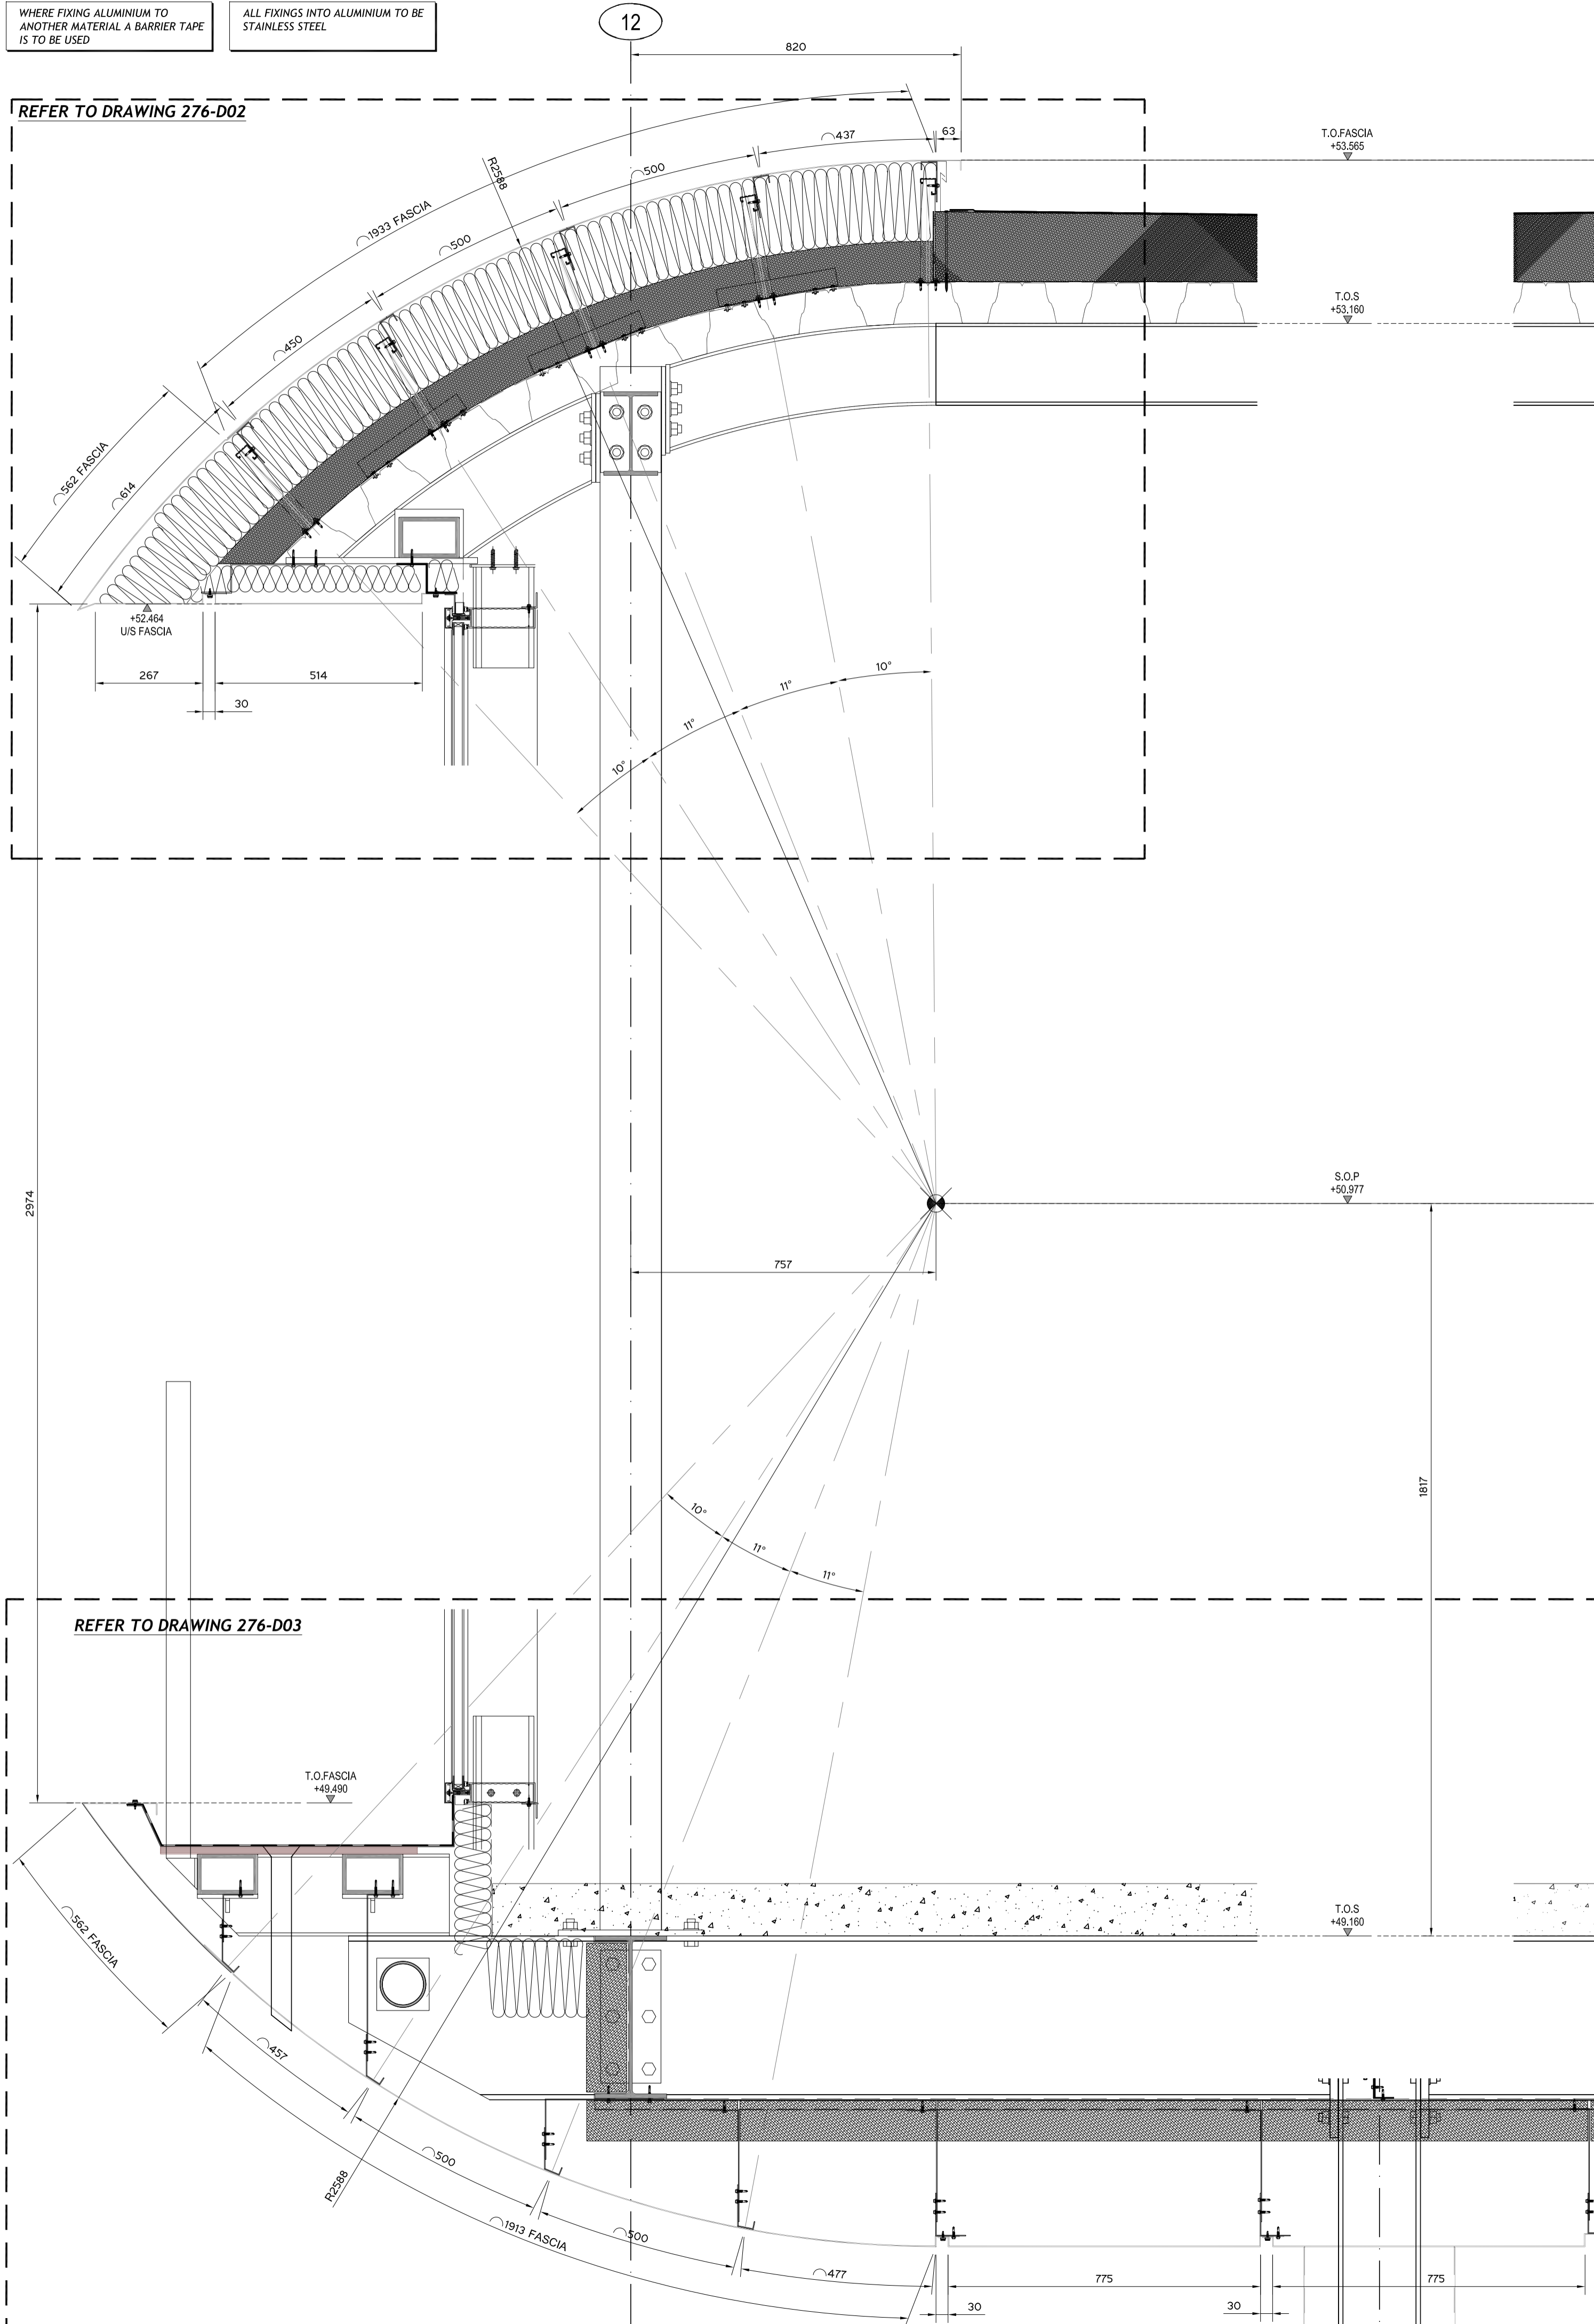

REFER TO DRAWING 276-D03

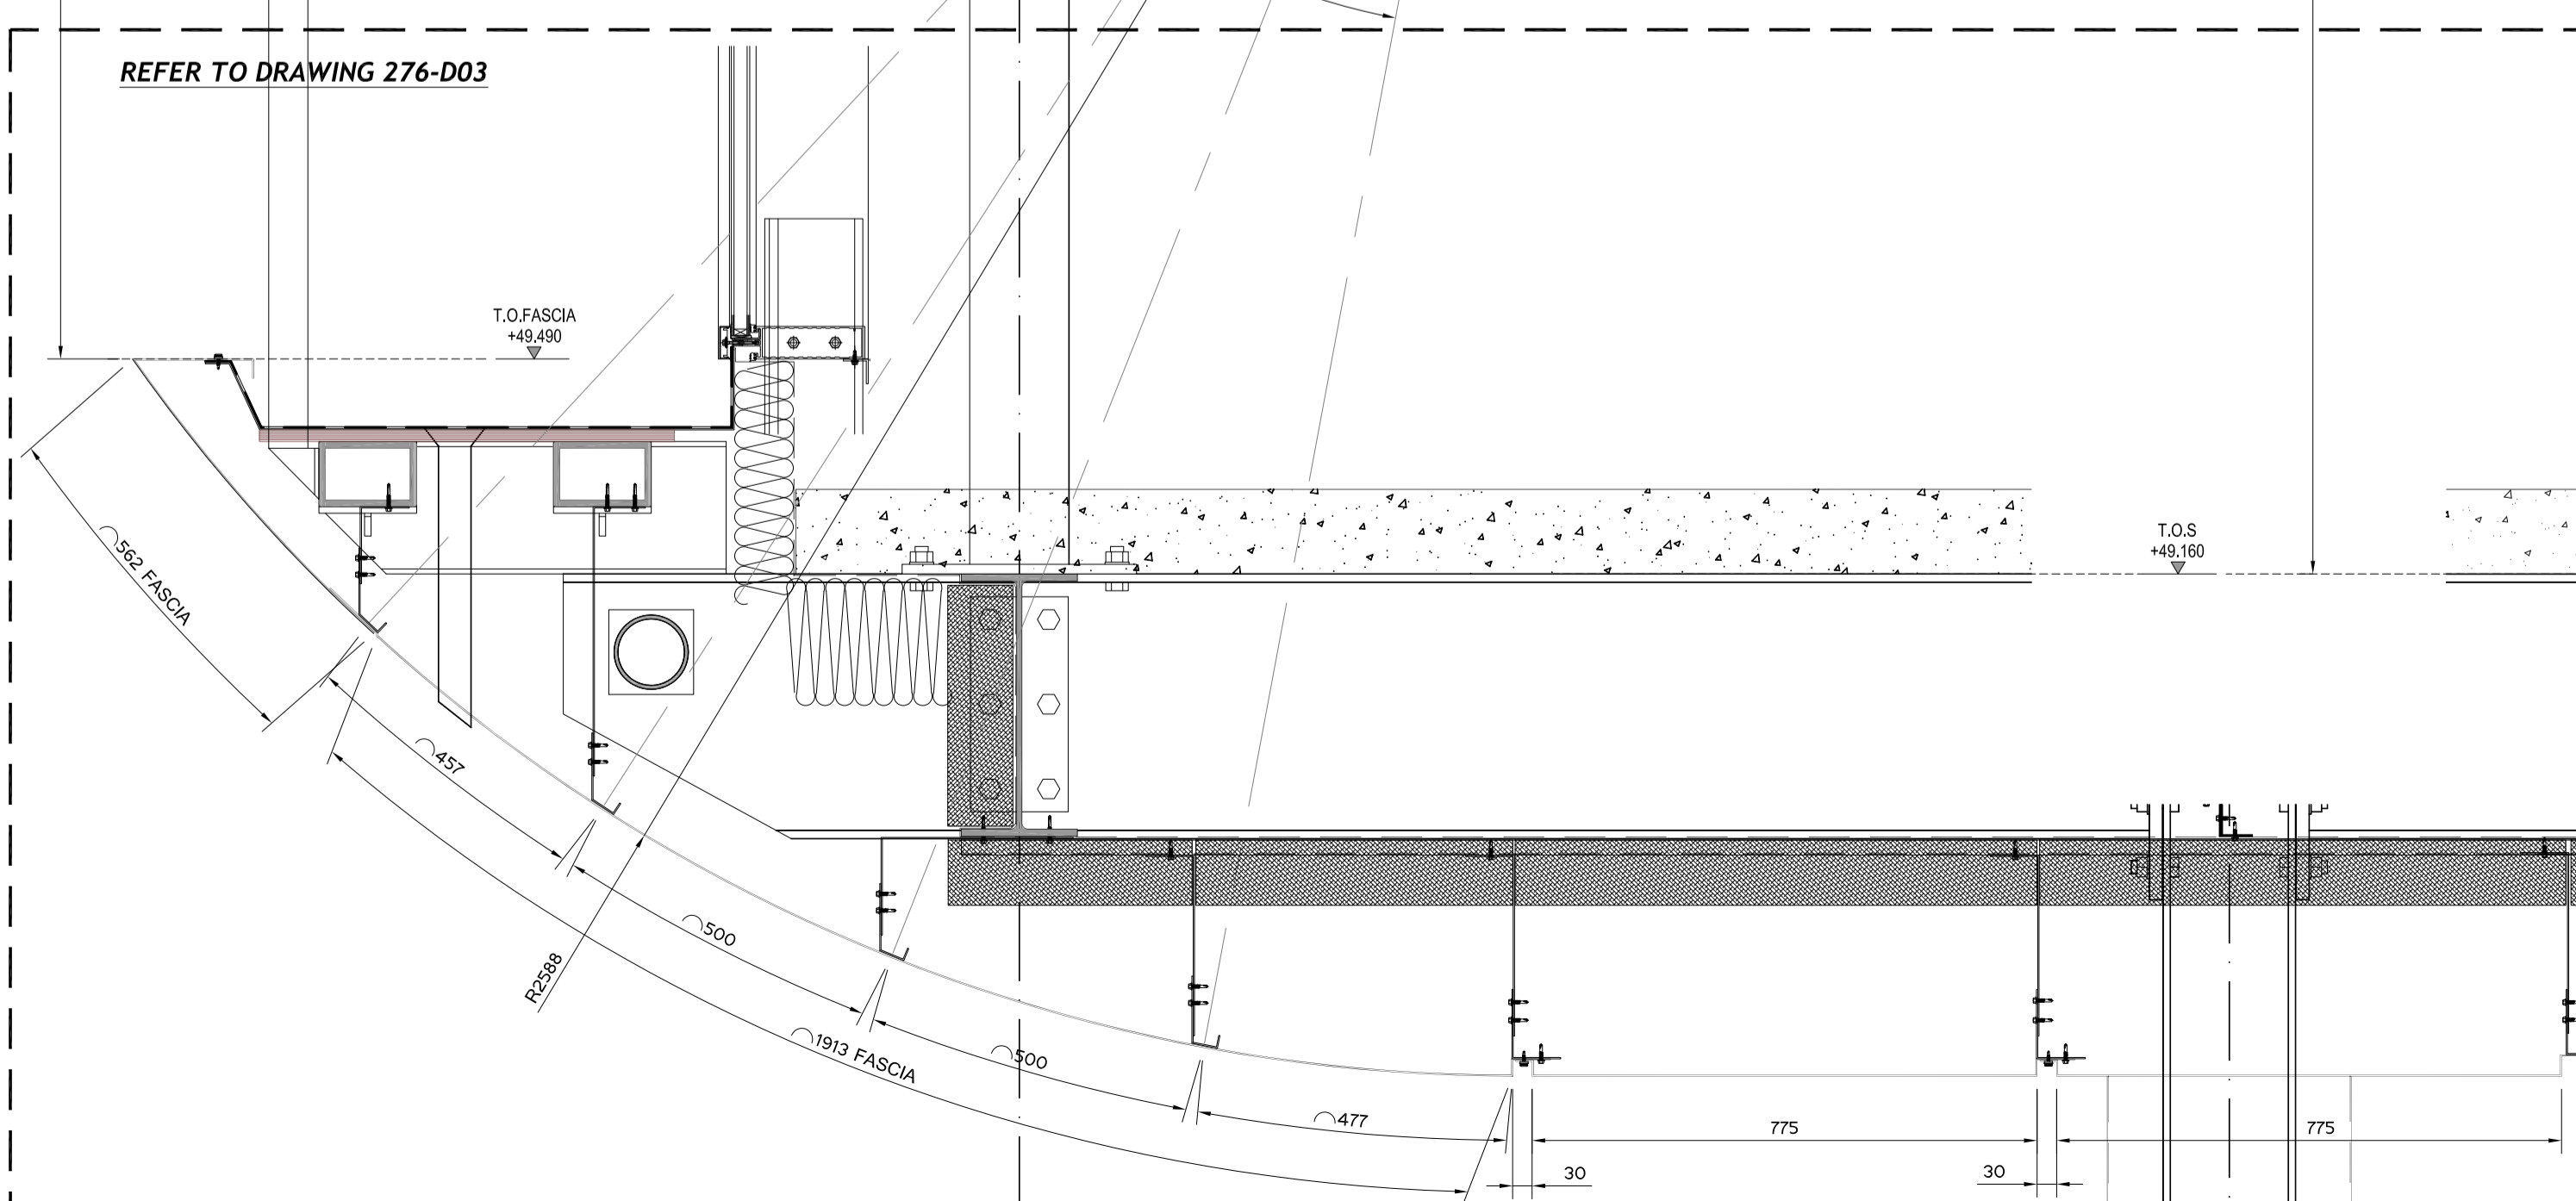

1.1

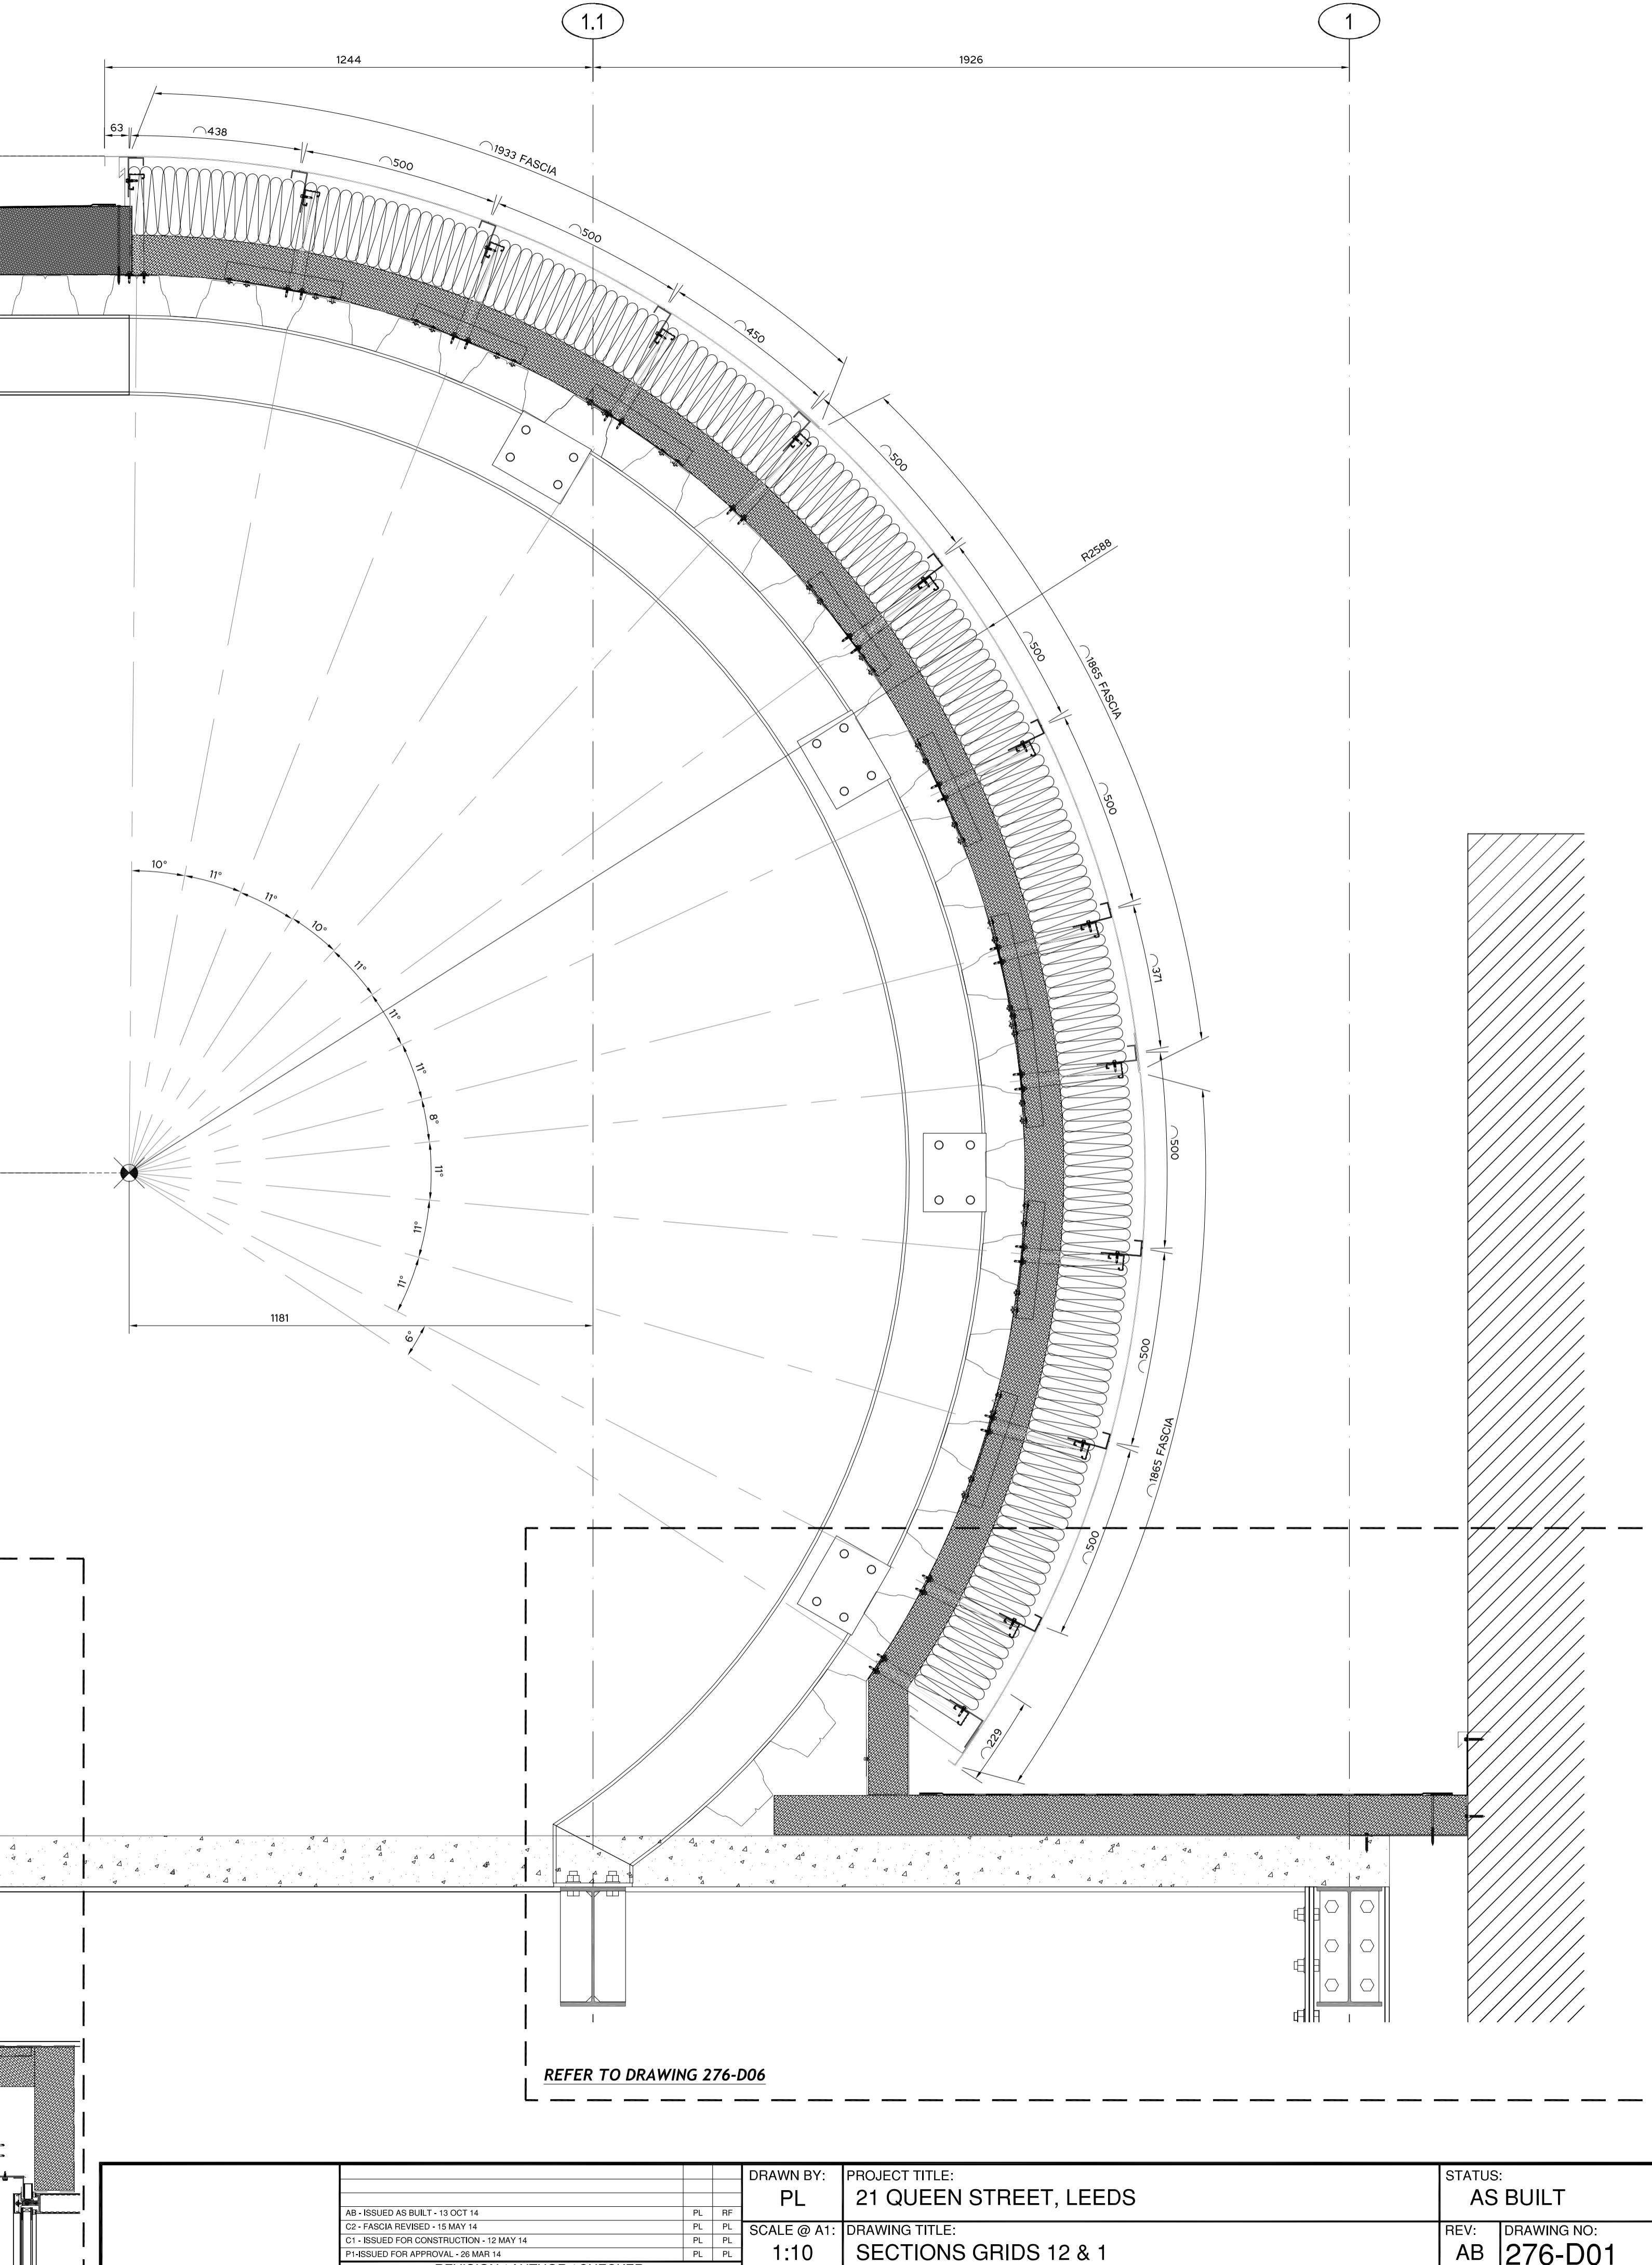

REFER TO DRAWING 276-D06

		DRAWN BY: PL	PROJECT TITLE: 21 QUEEN STREET, LEEDS	STATUS: AS BUILT
		SCALE @ A1: 1:10	DRAWING TITLE: SECTIONS GRIDS 12 & 1	REV: AB
				DRAWING NO: 276-D01
REVISION / AUTHOR / CHECKER				