




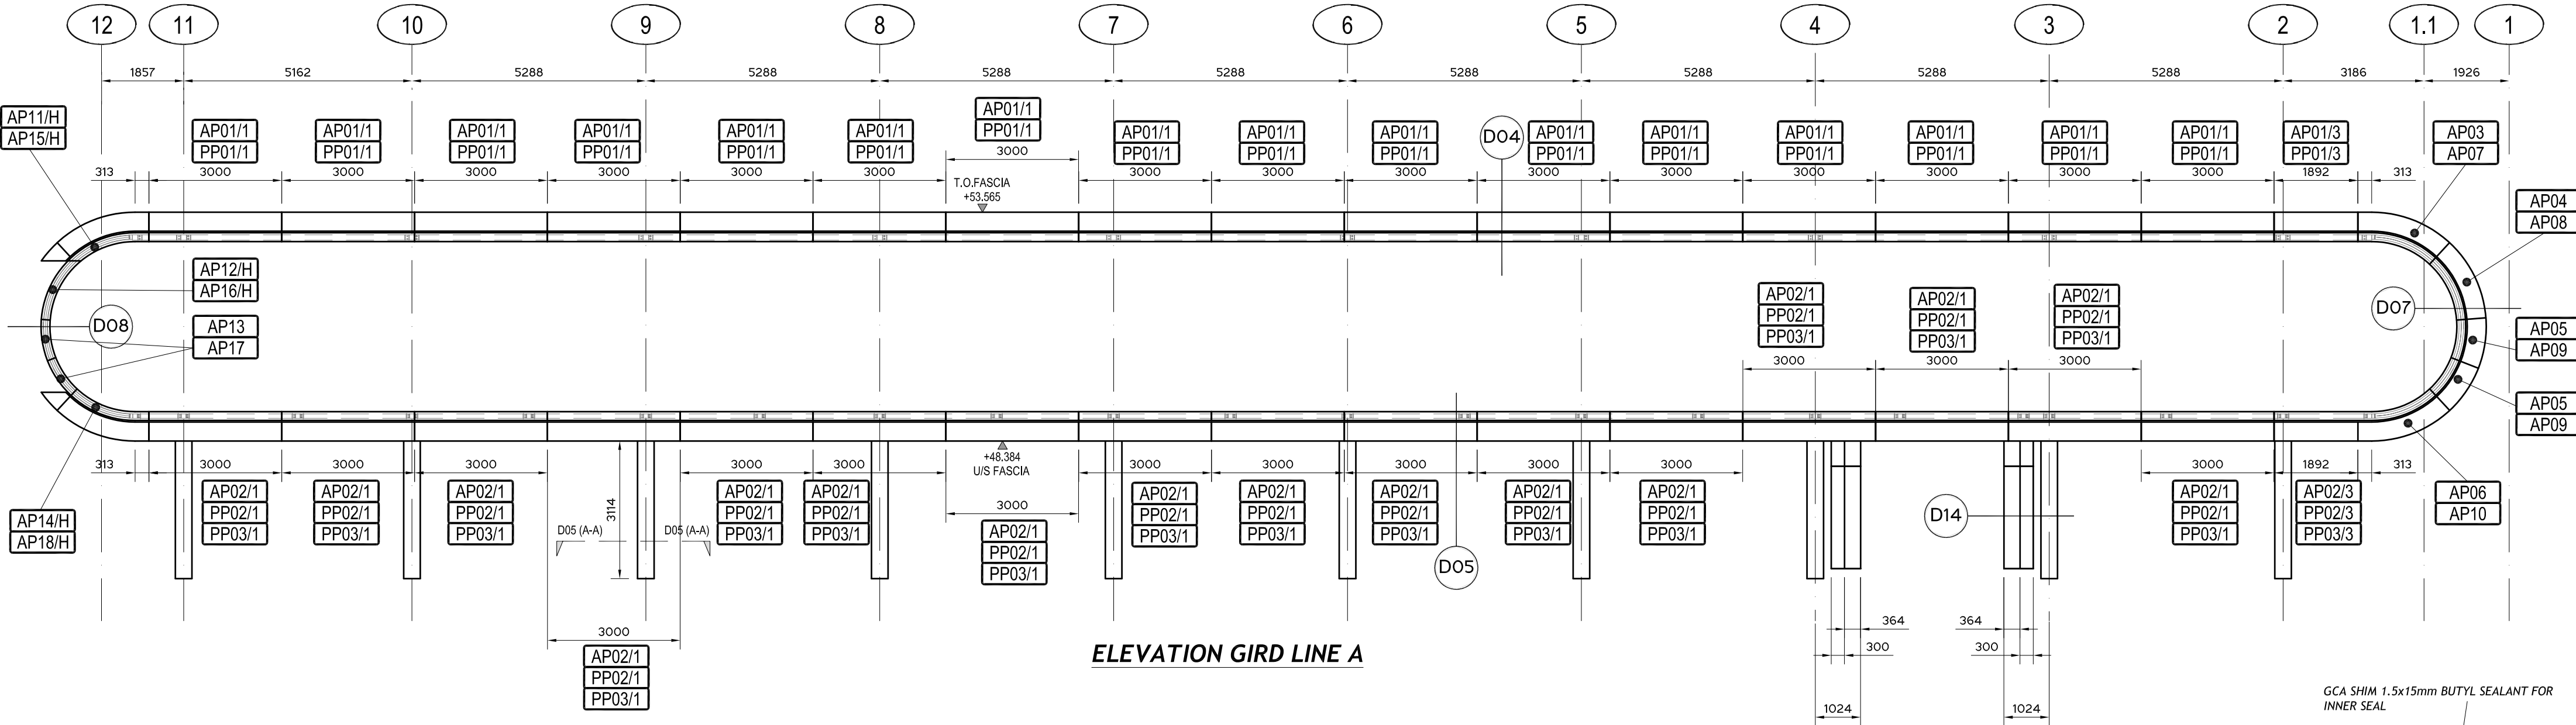


ELEVATION GIRD LINE A

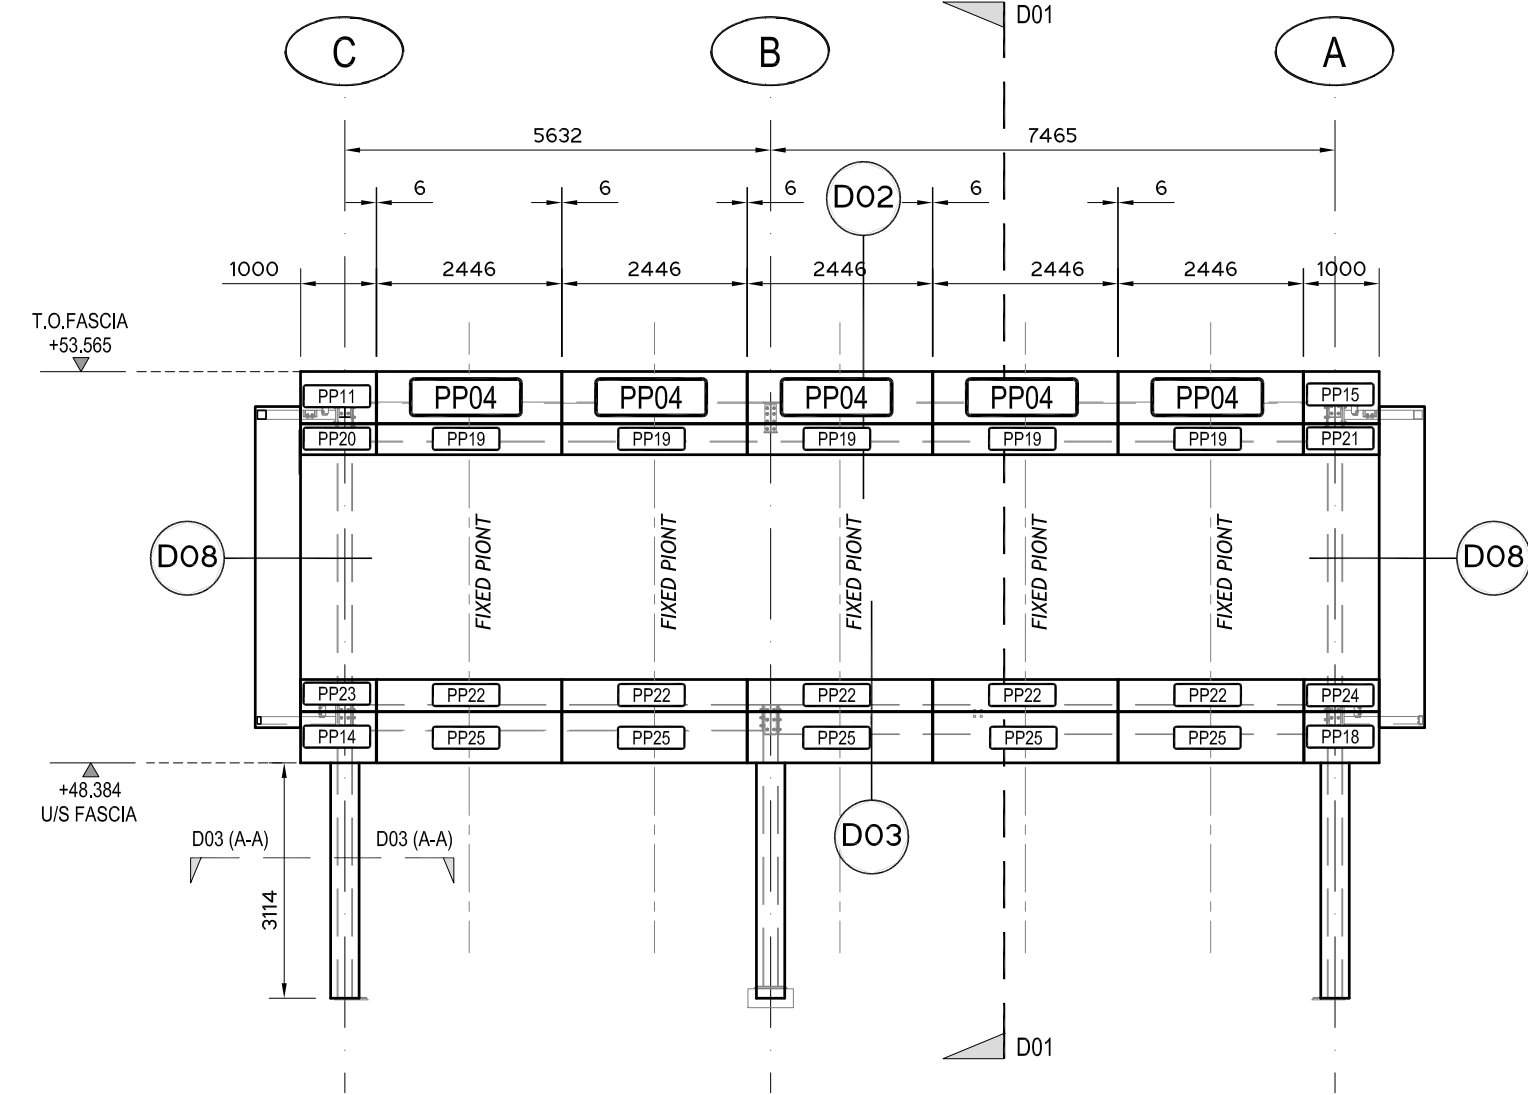

ELEVATION GIRD LINE 12

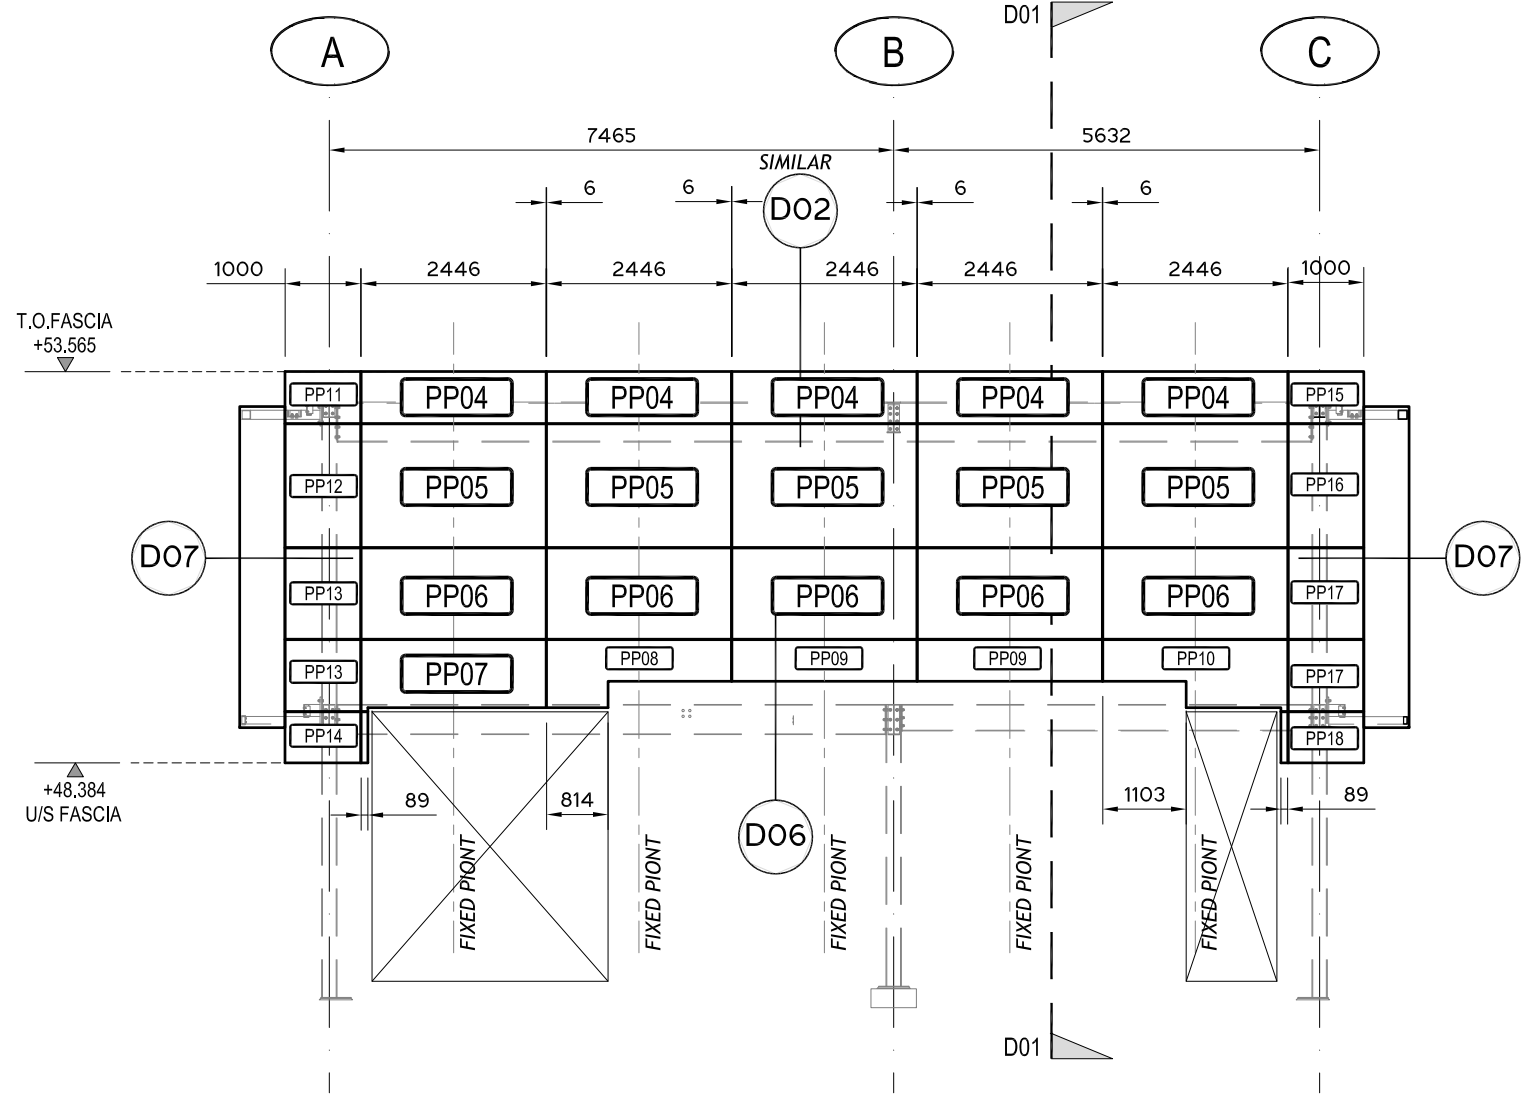

ELEVATION GIRD LINE 1

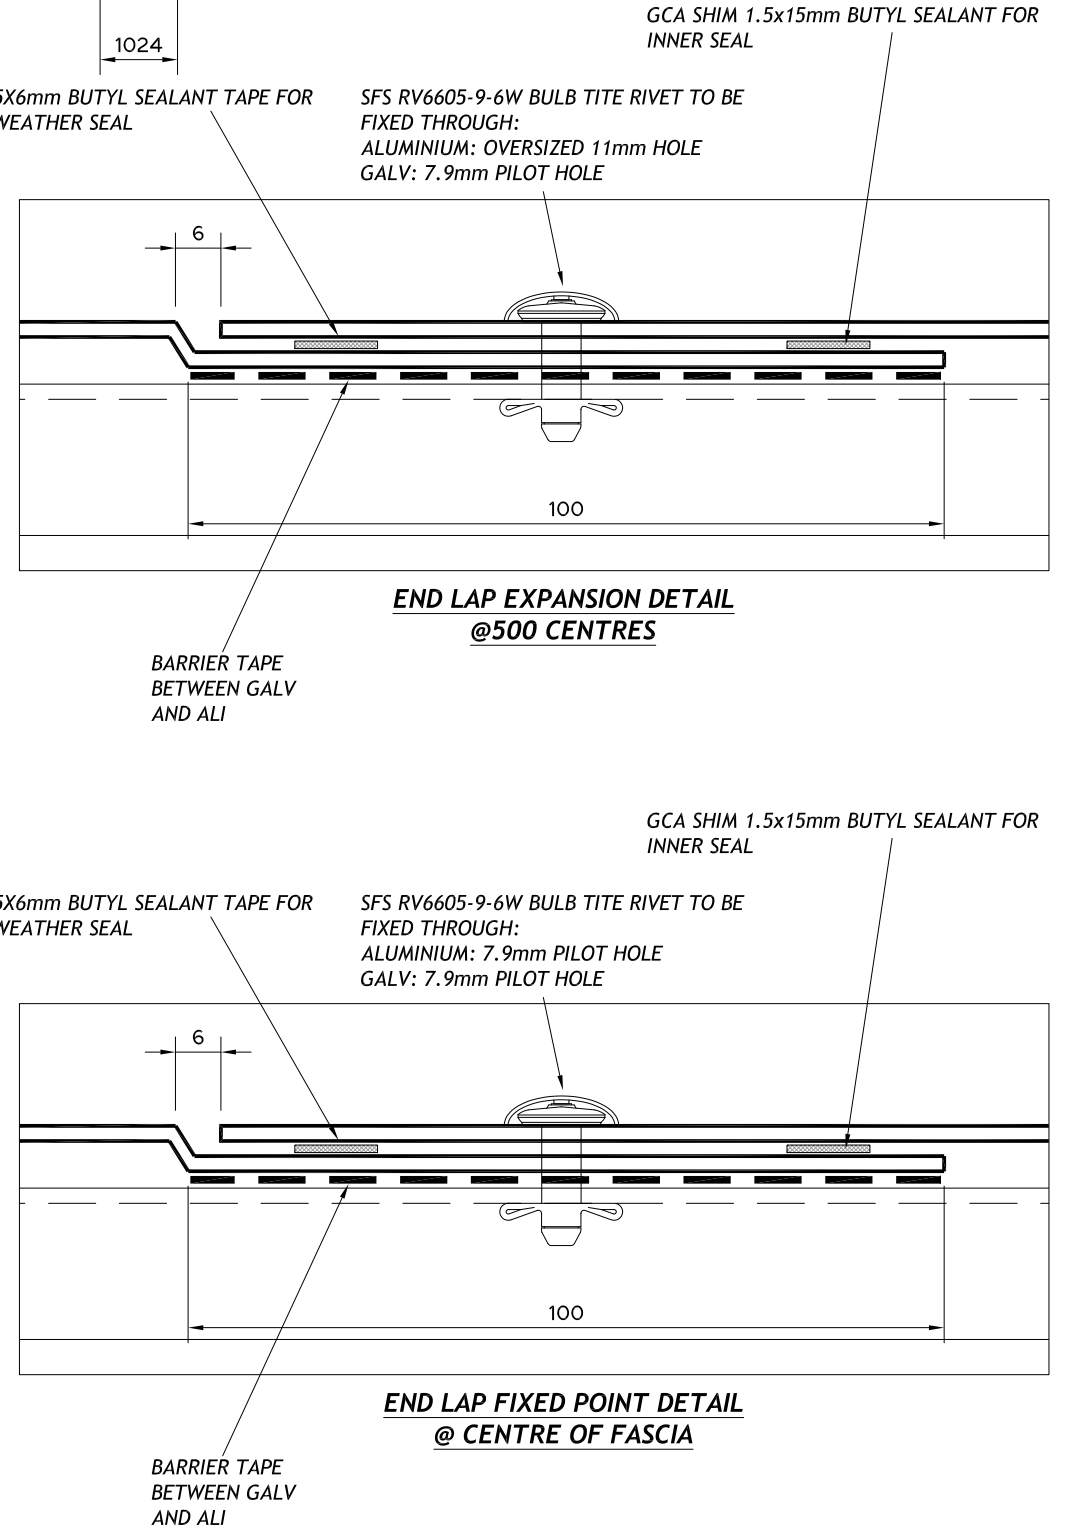

	AB - ISSUED AS BUILT - 13 OCT 14	PL	RF	DRAWN BY: PL	PROJECT TITLE: 21 QUEEN STREET, LEEDS	STATUS: AS BUILT	
	C4 - ANODISED FASCIA REFS ADDED - 22 JULY 14	PL	PL				
	C3 - FLASHING REFS ADDED - 06 JUNE 14	PL	PL	SCALE @ A2: 1:100	DRAWING TITLE: FASCIA ELEVATIONS GRIDS A, 12 & 1	REV: AB	DRAWING NO: 276-L02
	C2 - FASCIA REVISED - 15 MAY 14	PL	PL				
	C1 - ISSUED FOR CONSTRUCTION - 12 MAY 14	PL	PL				
	PHISSUED FOR APPROVAL - 26 MAR 14	PL	PL				
	REVISION / AUTHOR / CHECKER						