


WHERE FIXING ALUMINIUM TO ANOTHER MATERIAL A BARRIER TAPE IS TO BE USED

ALL FIXINGS INTO ALUMINIUM TO BE STAINLESS STEEL

A
C

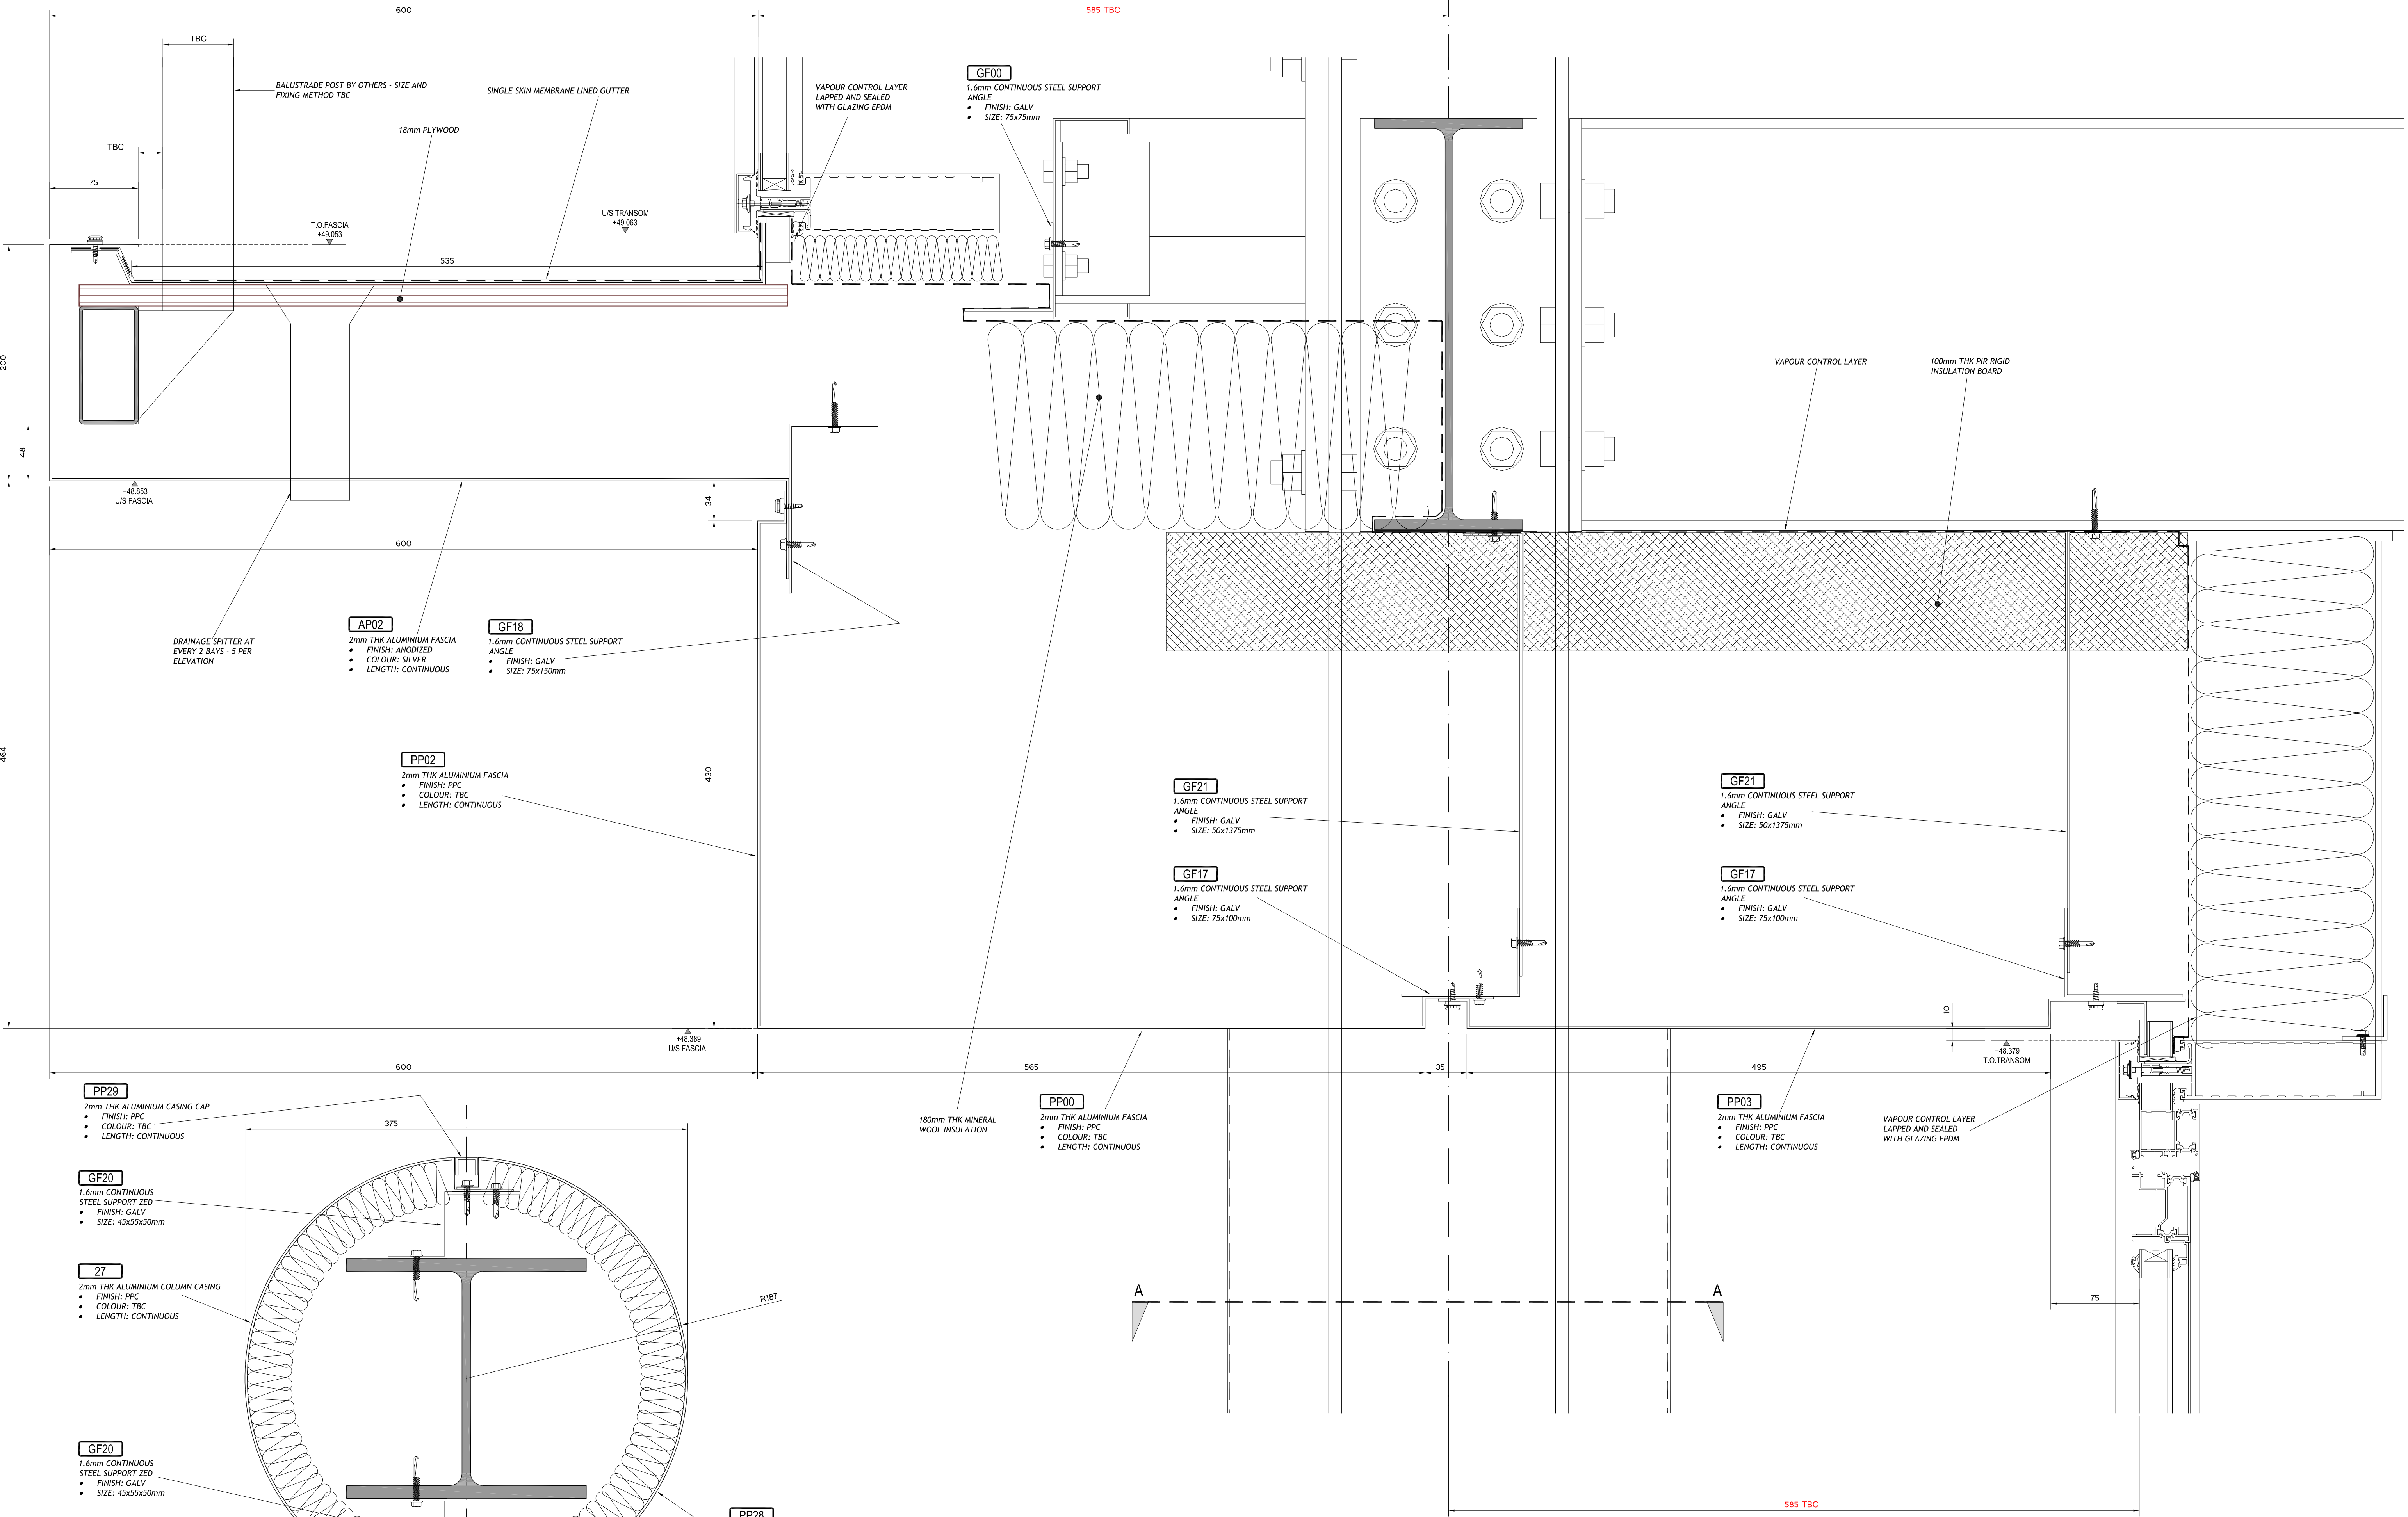

200
48
464

600
375
34
430
600
565
35
495
48.370
75

600

SECTION A-A

REVISION / AUTHOR / CHECKER		DRAWN BY: PL SCALE @ A1: 1:100	PROJECT TITLE: 21 QUEEN STREET, LEEDS DRAWING TITLE: VERGE CILL DETAIL	STATUS: AS BUILT REV: AB DRAWING NO: 276-D05
AB - ISSUED AS BUILT - 13 OCT 14 G1 - ISSUED FOR CONSTRUCTION - 13 MAY 14 P1 - ISSUED FOR APPROVAL - 26 MAR 14		PL RF PL PL PL PL		

Drawing file: