

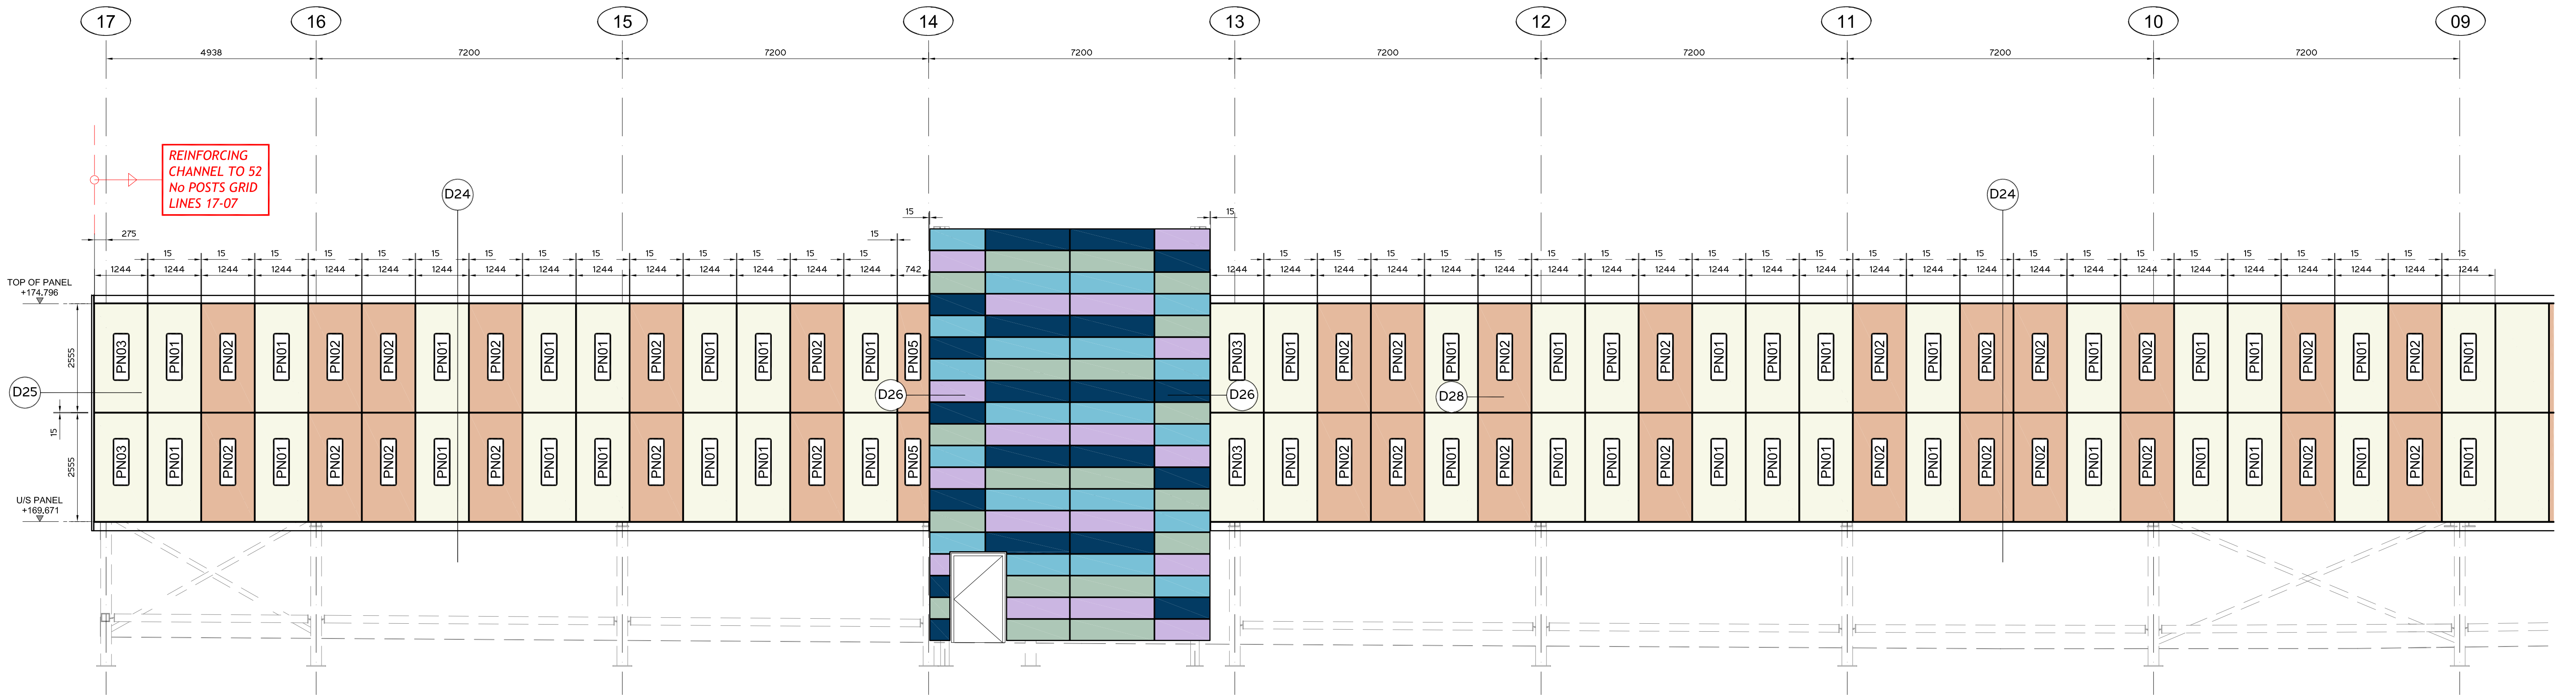
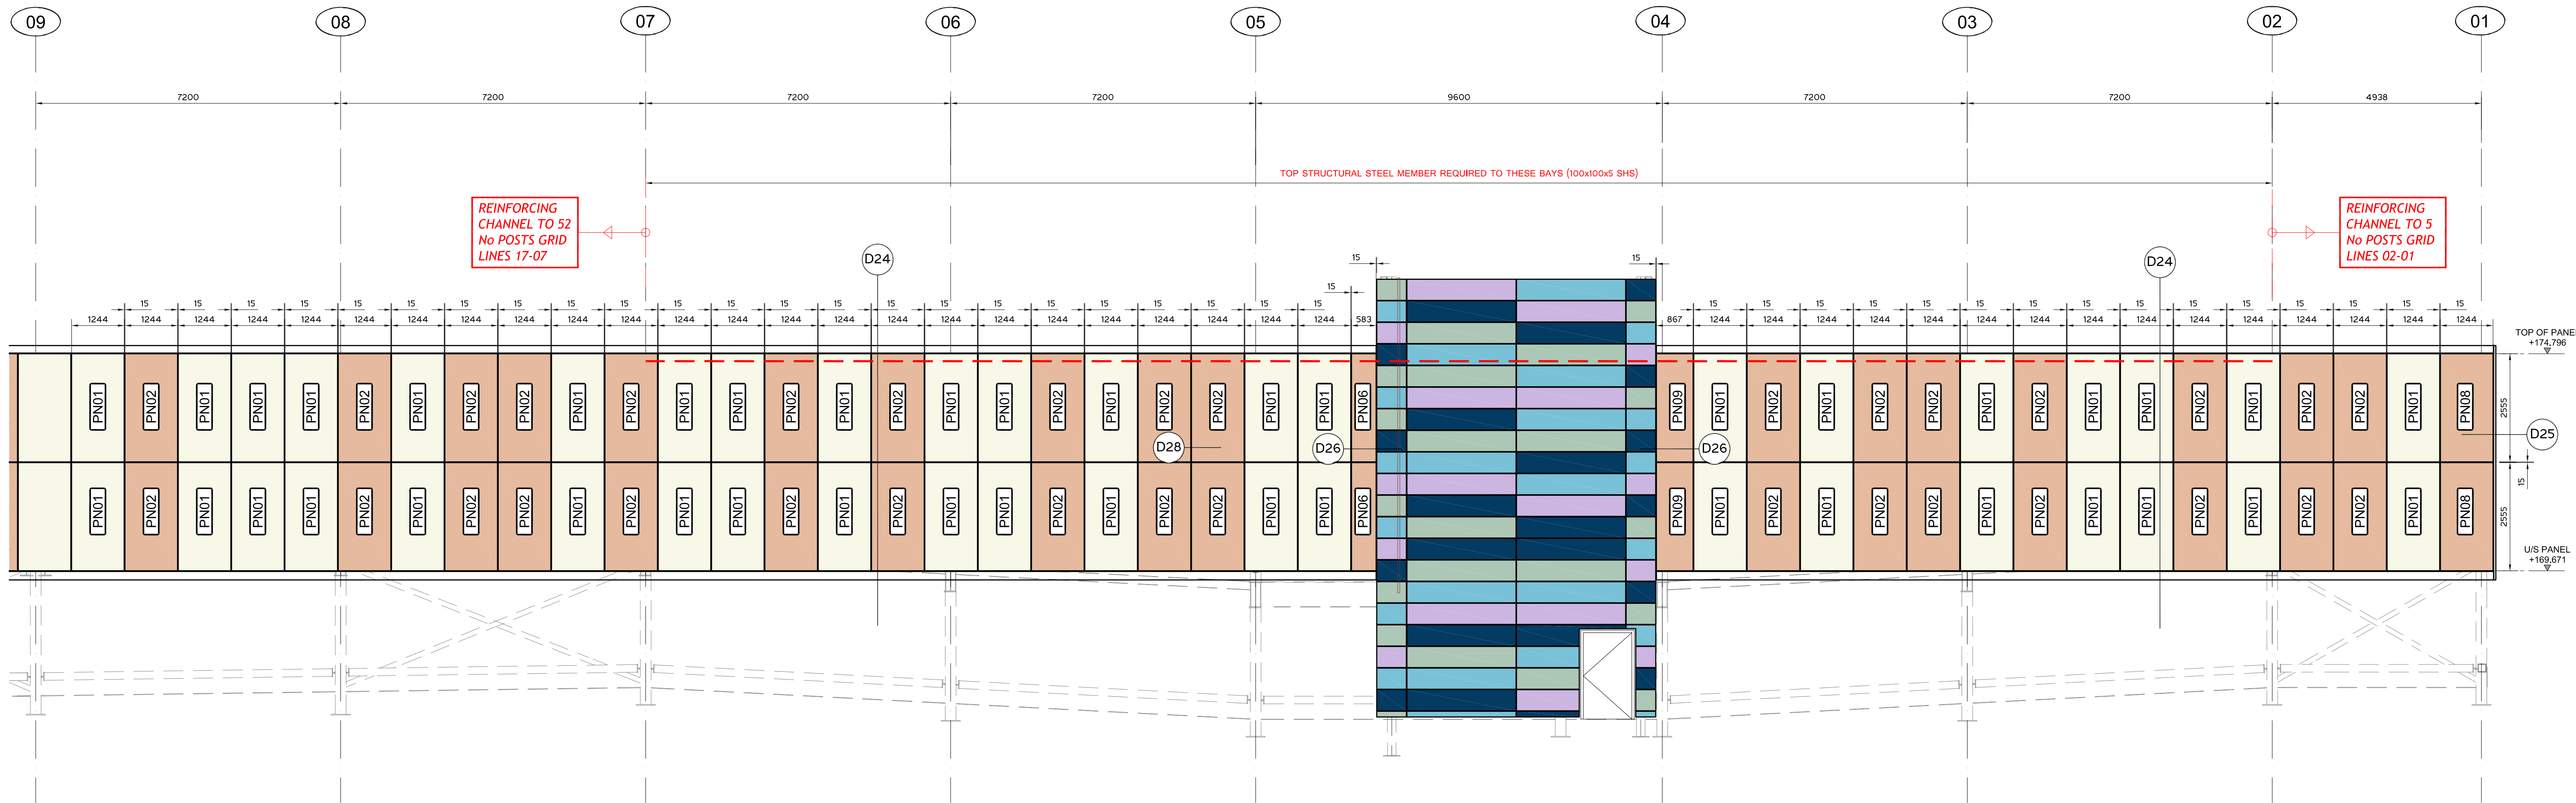


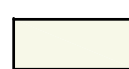

ELEVATION ON GRID A

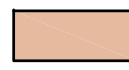

ELEVATION ON GRID A
(CONTINUED)

-  = ALUMINIUM VISION WEBB ANALOK 541
ANODIZED BRONZE FINISHED
-  = ALUMINIUM VISION WEBB ANALOK 545
ANODIZED BRONZE FINISHED

	AB - ISSUED AS BUILT - 13 SEP 13		DRAWN BY:	PL	PROJECT TITLE:	NEW SQUARE - WEST BROMWICH		STATUS:	
	C2 - REINFORCEMENT NOTE ADDED - 16 APR 13	PL	SCALE @ A1:	1:75	DRAWING TITLE:	ASH SCREEN LAYOUT GRID A		REV:	DRAWING NO:
	C1 - ISSUED FOR CONSTRUCTION - 22 MAR 13	PL						AB	966-L10
	P3 - MESH SHEET SIZES REVISED - 20 MAR 13	PL							
REVISION / AUTHOR / CHECKER		PL							
		PL							
		PL							
		PL							

Drawing file: