



SCALE 1:2.5

NOTE: FIXING SPECIFICATION TO BE CONFIRMED SUBJECT TO PULL-OUT TESTS

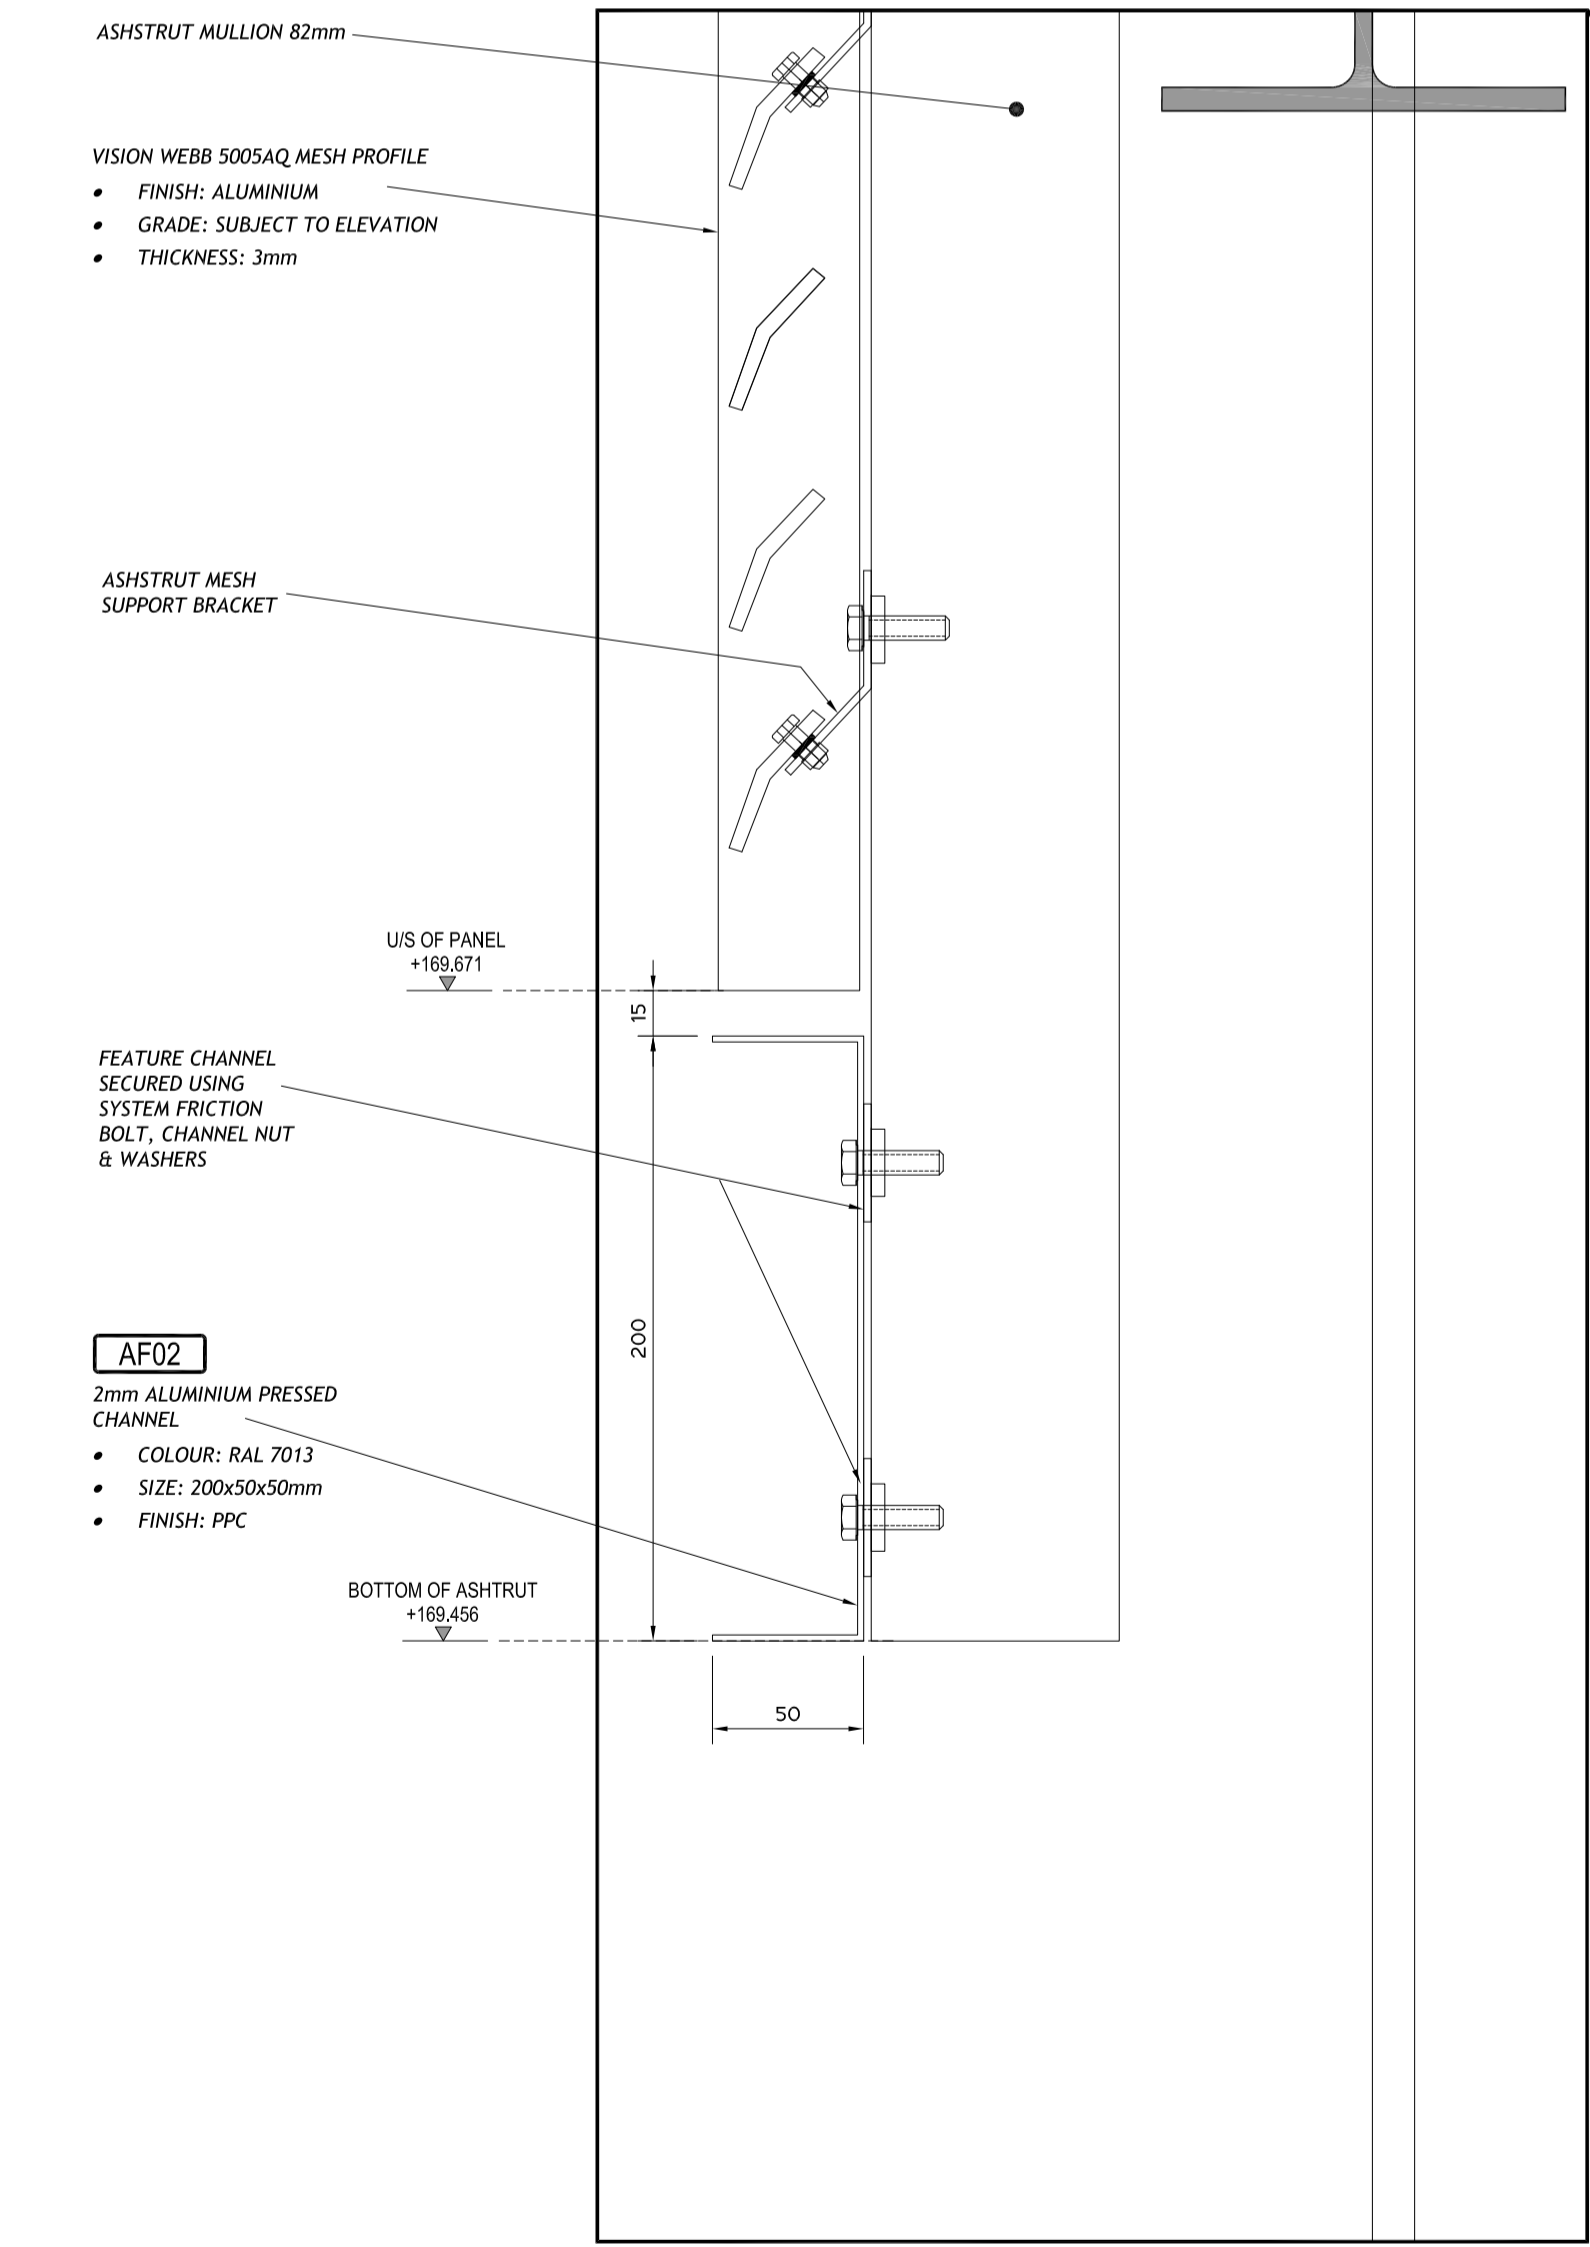


SCALE 1:2.5

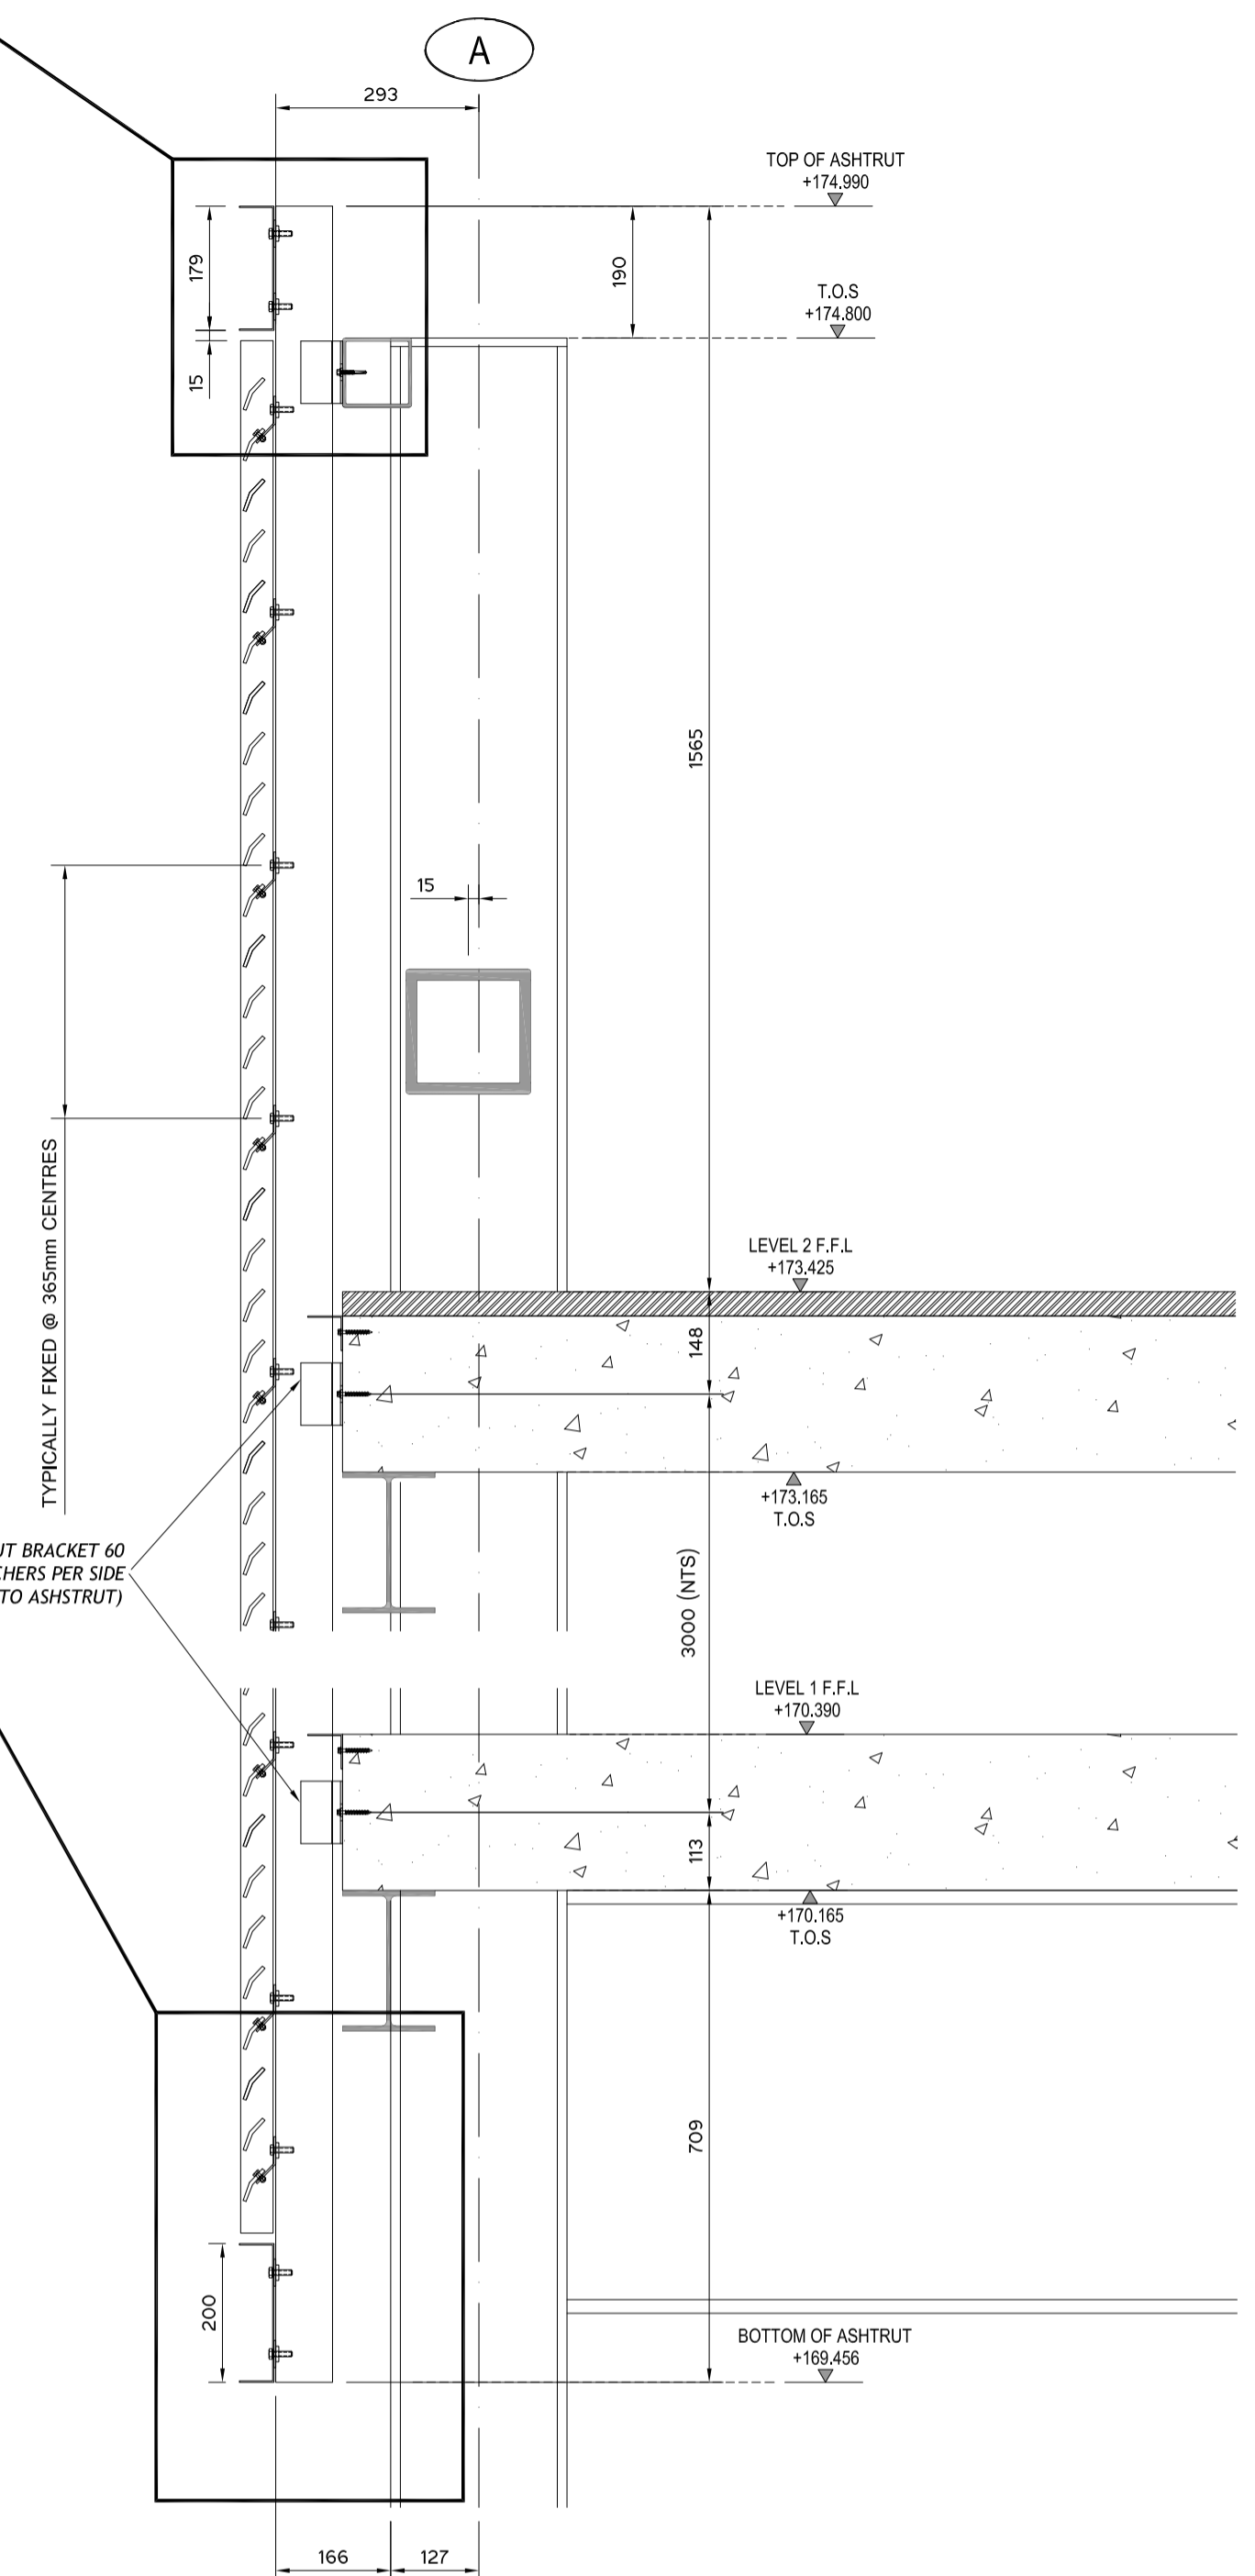


NOTE: SHS AT +174.800 NOT APPLICABLE THROUGH GRID A 1-2 & 7-17

NOTE: REINFORCED ASHTRUT REQUIRED WHERE TOP SHS SUPPORT NOT APPLICABLE

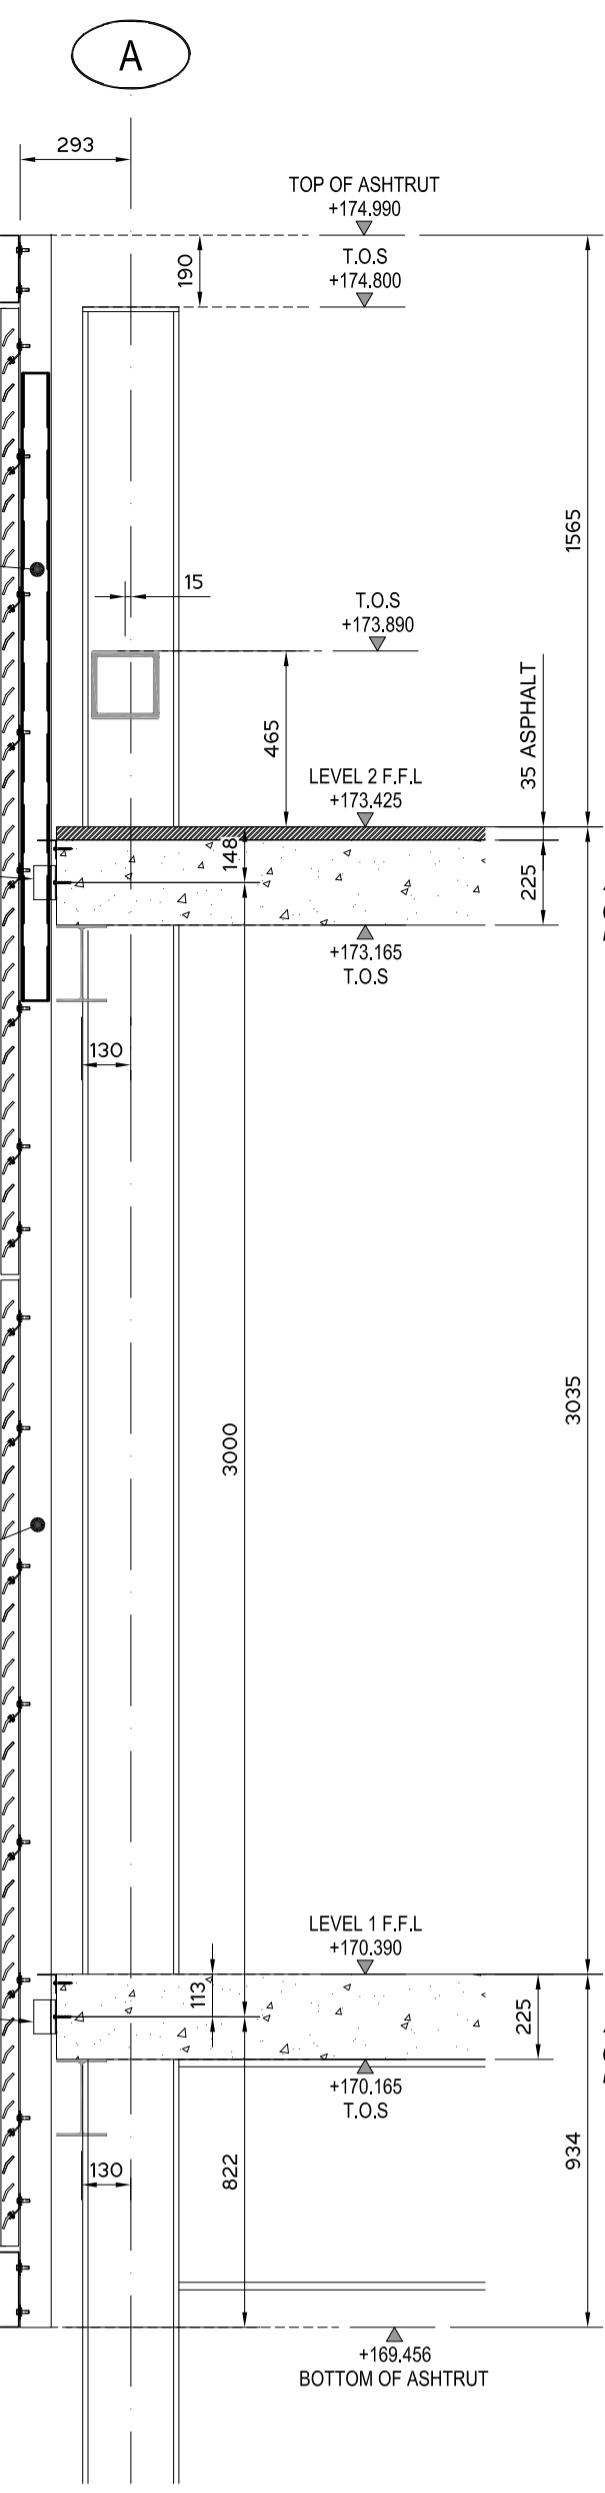


SECTION THROUGH GRID A (BETWEEN GRIDS 1-2 & 7-17)

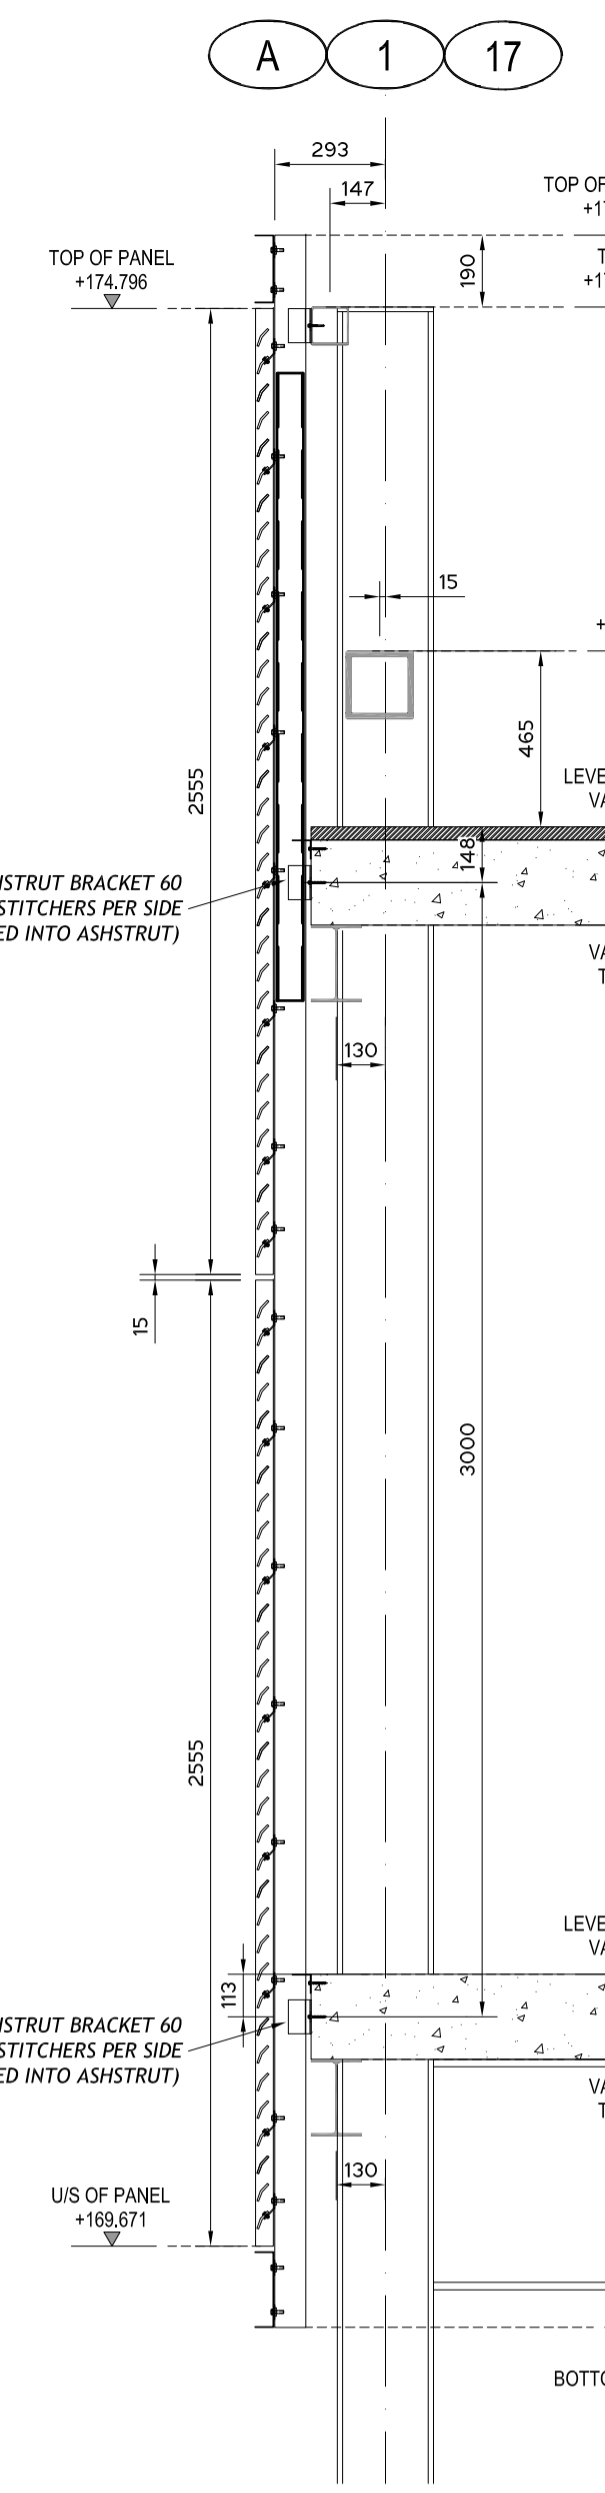


SECTION THROUGH GRID A (BETWEEN GRIDS 2-4 & 5-7)

NOTE: SHS AT +174.800 REQUIRED AS DRAWN

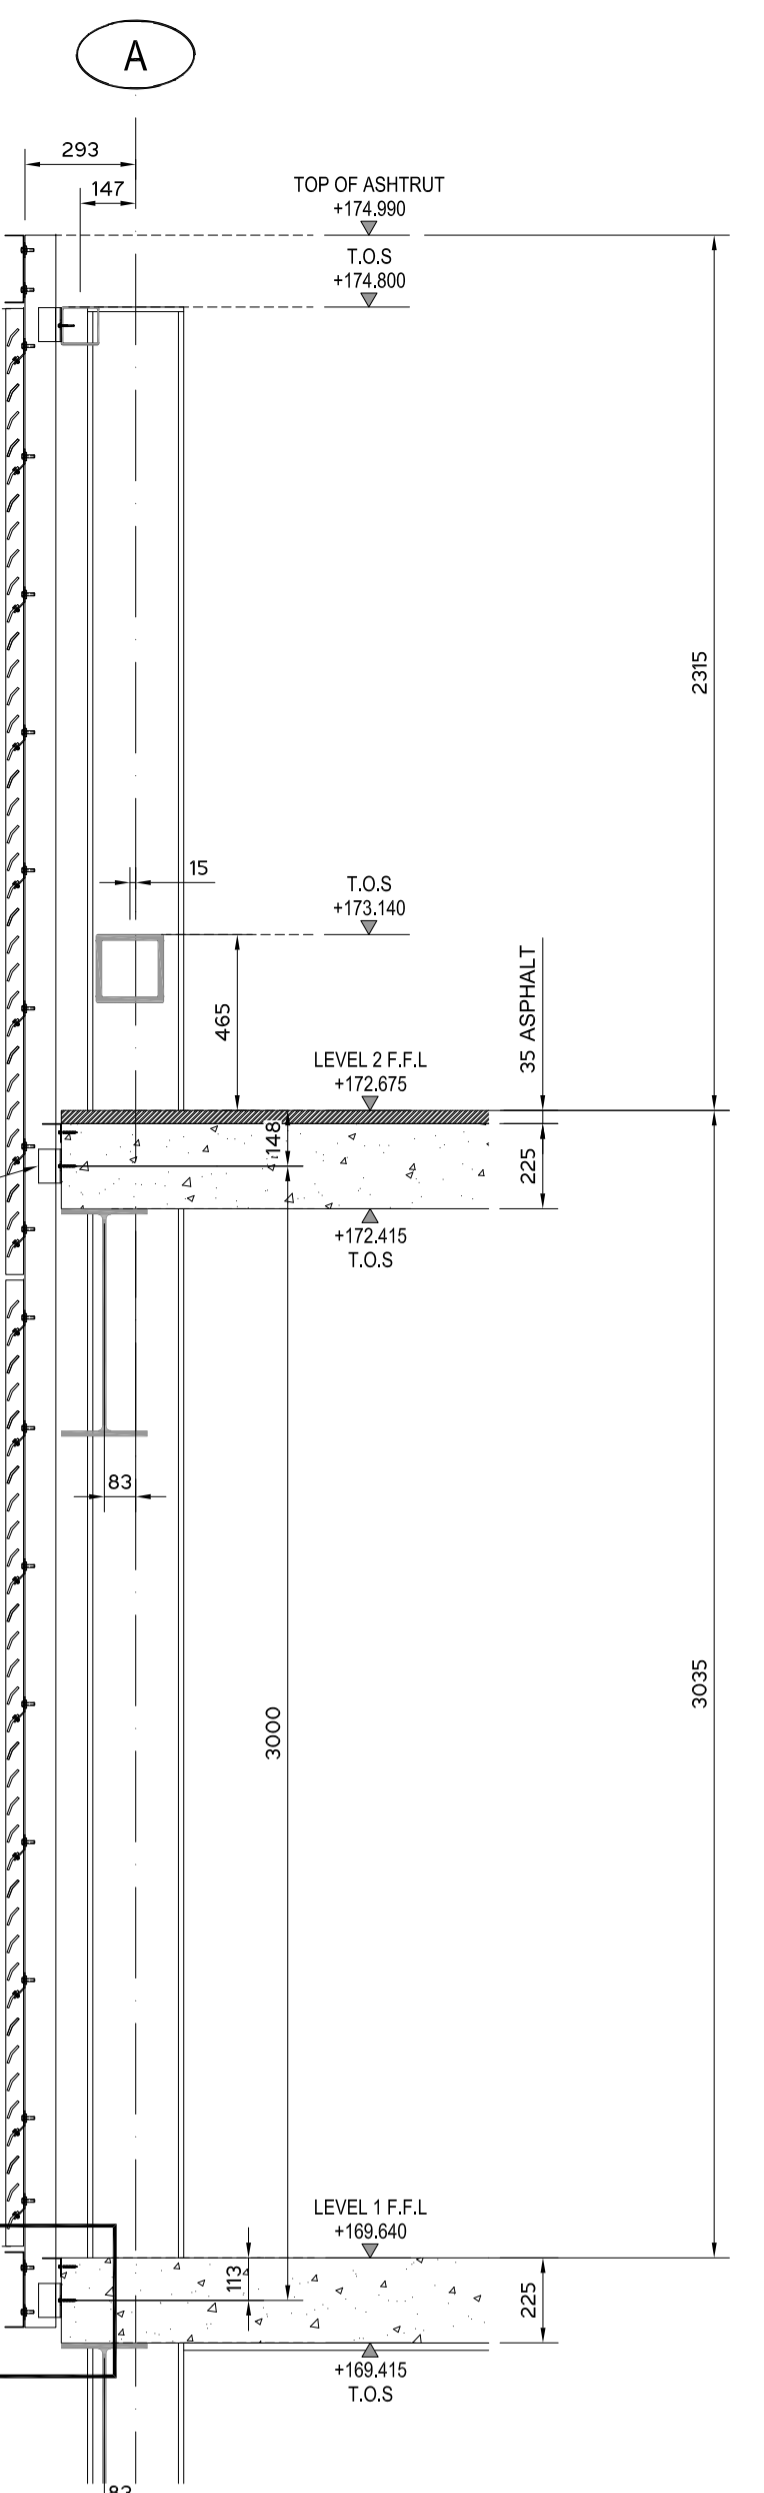

SECTION THROUGH GRID A (BETWEEN GRIDS 4-5)

CONTINUOUS ANGLE FIXED TO EACH SLAB TO MEET BUILDING REGULATIONS K3 3.3

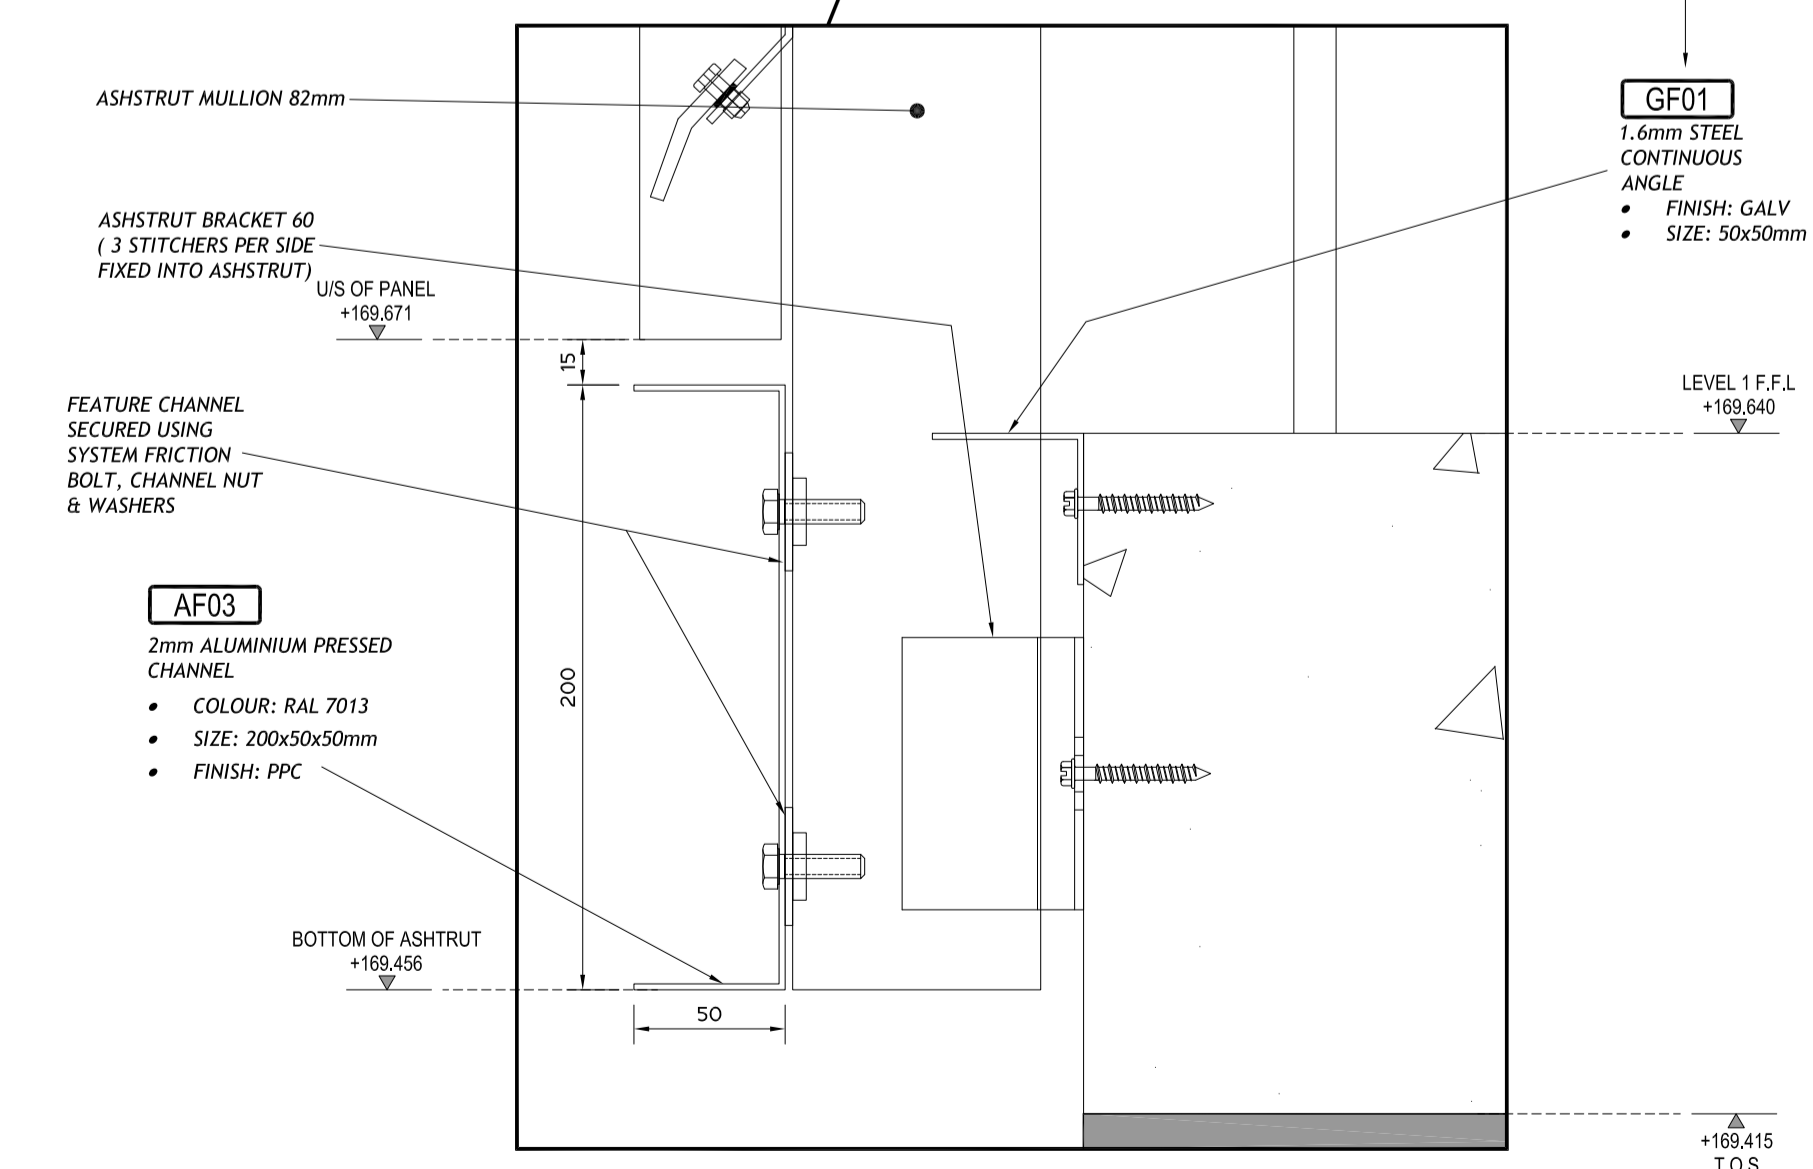

SCALE 1:2.5

AB - ISSUED AS BUILT - 13 SEP 13	PL	AL	PROJECT TITLE:	STATUS:
C2-BRACKET SETTING OUT REVISED - 16 APR 13	PL	AL	NEW SQUARE - WEST BROMWICH	AS BUILT
C1-ISSUED FOR CONSTRUCTION - 22 MAR 13	PL	AL	DRAWING TITLE:	REV: AB
P3-STEELWORK AND LEVELS REVISED - 20 MAR 13	PL	AL	ASHSCREEN HEAD AND BASE DETAILS	D24
FRAMESH PANEL SIZES REVISED	PL	AL	SCALE @ A1:	
P1-ISSUED FOR APPROVAL - 08 JAN 13	AL	AL	1:10, 1:20	
REVISION / AUTHOR / CHECKER			DRAWING FILE:	