


- KINGZIP THK STANDING SEAM ROOF PANEL**
- ALUMINIUM OUTER FACE STUCCO EMBOSSED
 - MILL FINISH
 - 110mm THK PIR INSULATION CORE.
 - 0.4mm THK WHITE POLYESTER COATED LINER.

PVC BARRIER TAPE BETWEEN ALL STEEL & ALUMINIUM TO AVOID BIMETALLIC CORROSION

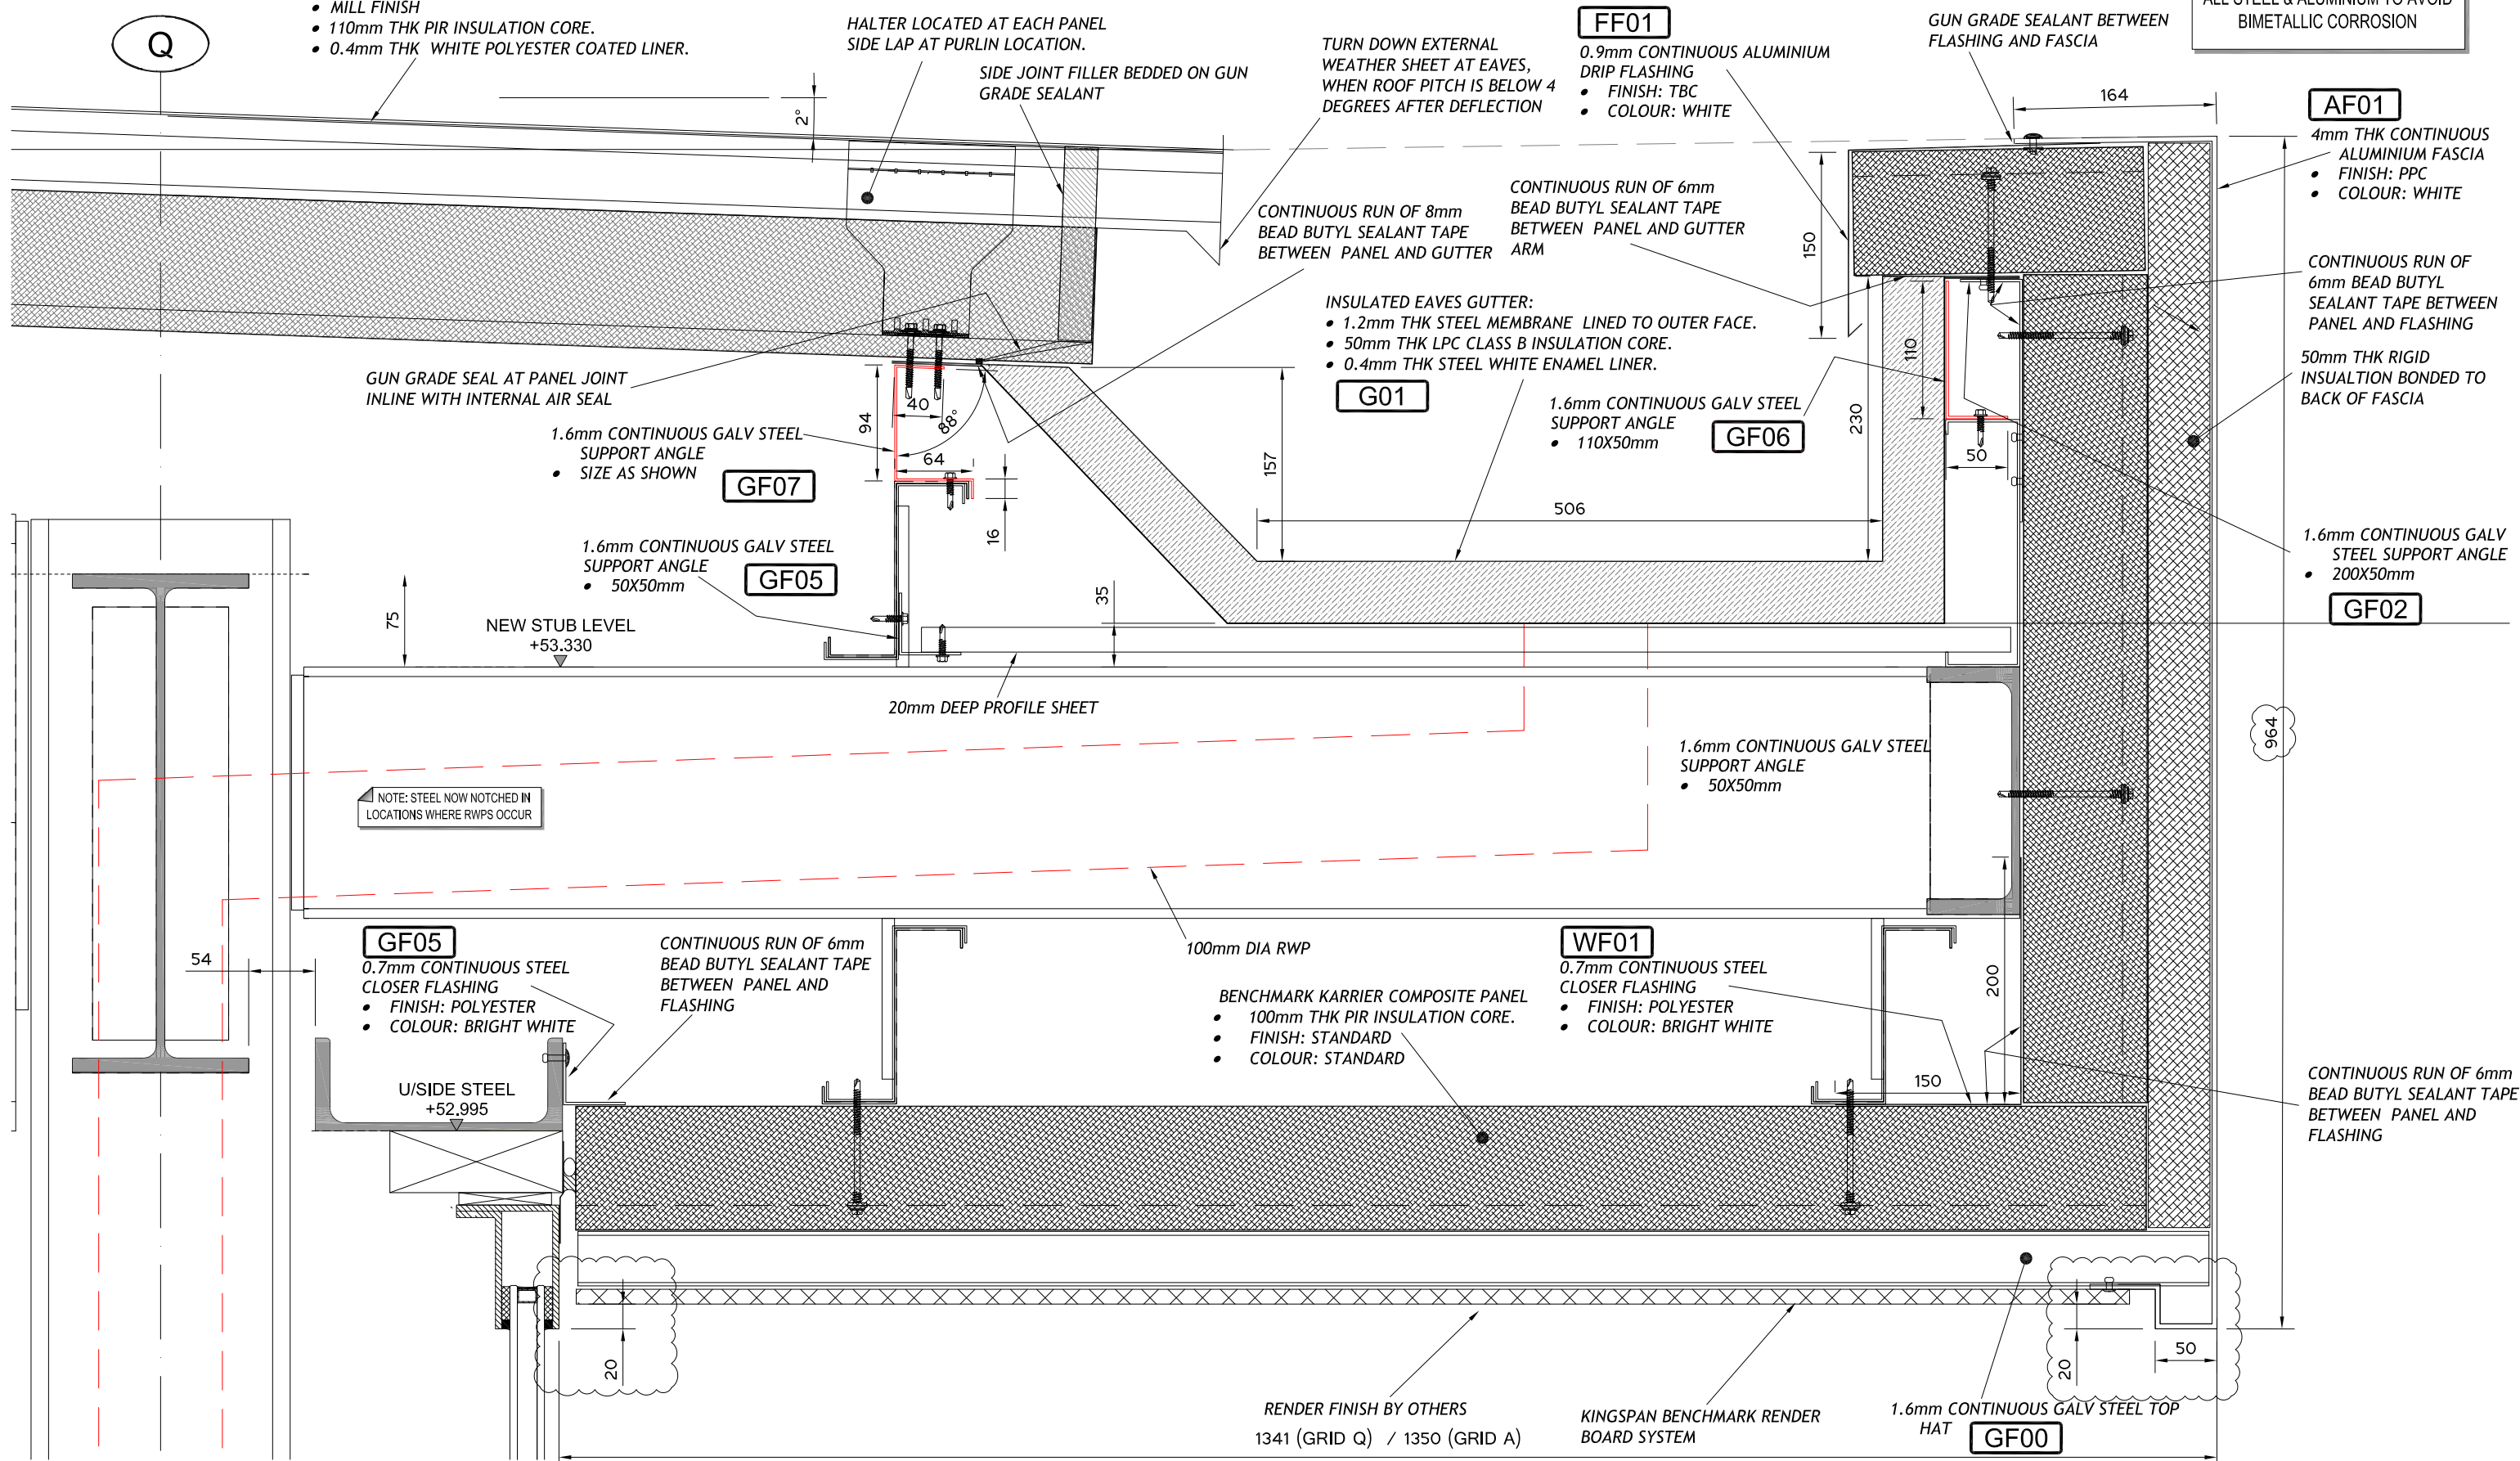

| REVISION / AUTHOR / CHECKER | AL | RF |
|--------------------------------------|----|----|
| AB-ISSUED AS BUILT - 04 Jul 16 | AL | RF |
| C2 -SOFFIT REVISED - 10 FEB 16 | RR | RF |
| AB-ISSUED AS BUILT - 04 Jul 16 | RF | RF |
| P6 - SUPPORT REVISED - 05 JAN 16 | RR | RF |
| P5 - REVISED TO COMMENTS - 15 DEC 15 | RR | RF |
| P4 - REVISED TO COMMENTS - 10 DEC 15 | RR | RF |
| P3 - STEEL NOTE RVISED - 26 NOV 15 | RR | RF |
| P2 - RWO INFO ADDED - 22 OCT 15 | RR | RF |
| P1-ISSUED FOR APPROVAL - 12 OCT 15 | RR | RF |

DRAWN BY:
RR

SCALE @ A3:
1:5

PROJECT TITLE:
ASTON MARTIN

DRAWING TITLE:
EAVES DETAIL

STATUS:
AS BUILT

REV:
AB

DRAWING NO.:
D01