



ELEVATION - GRID A

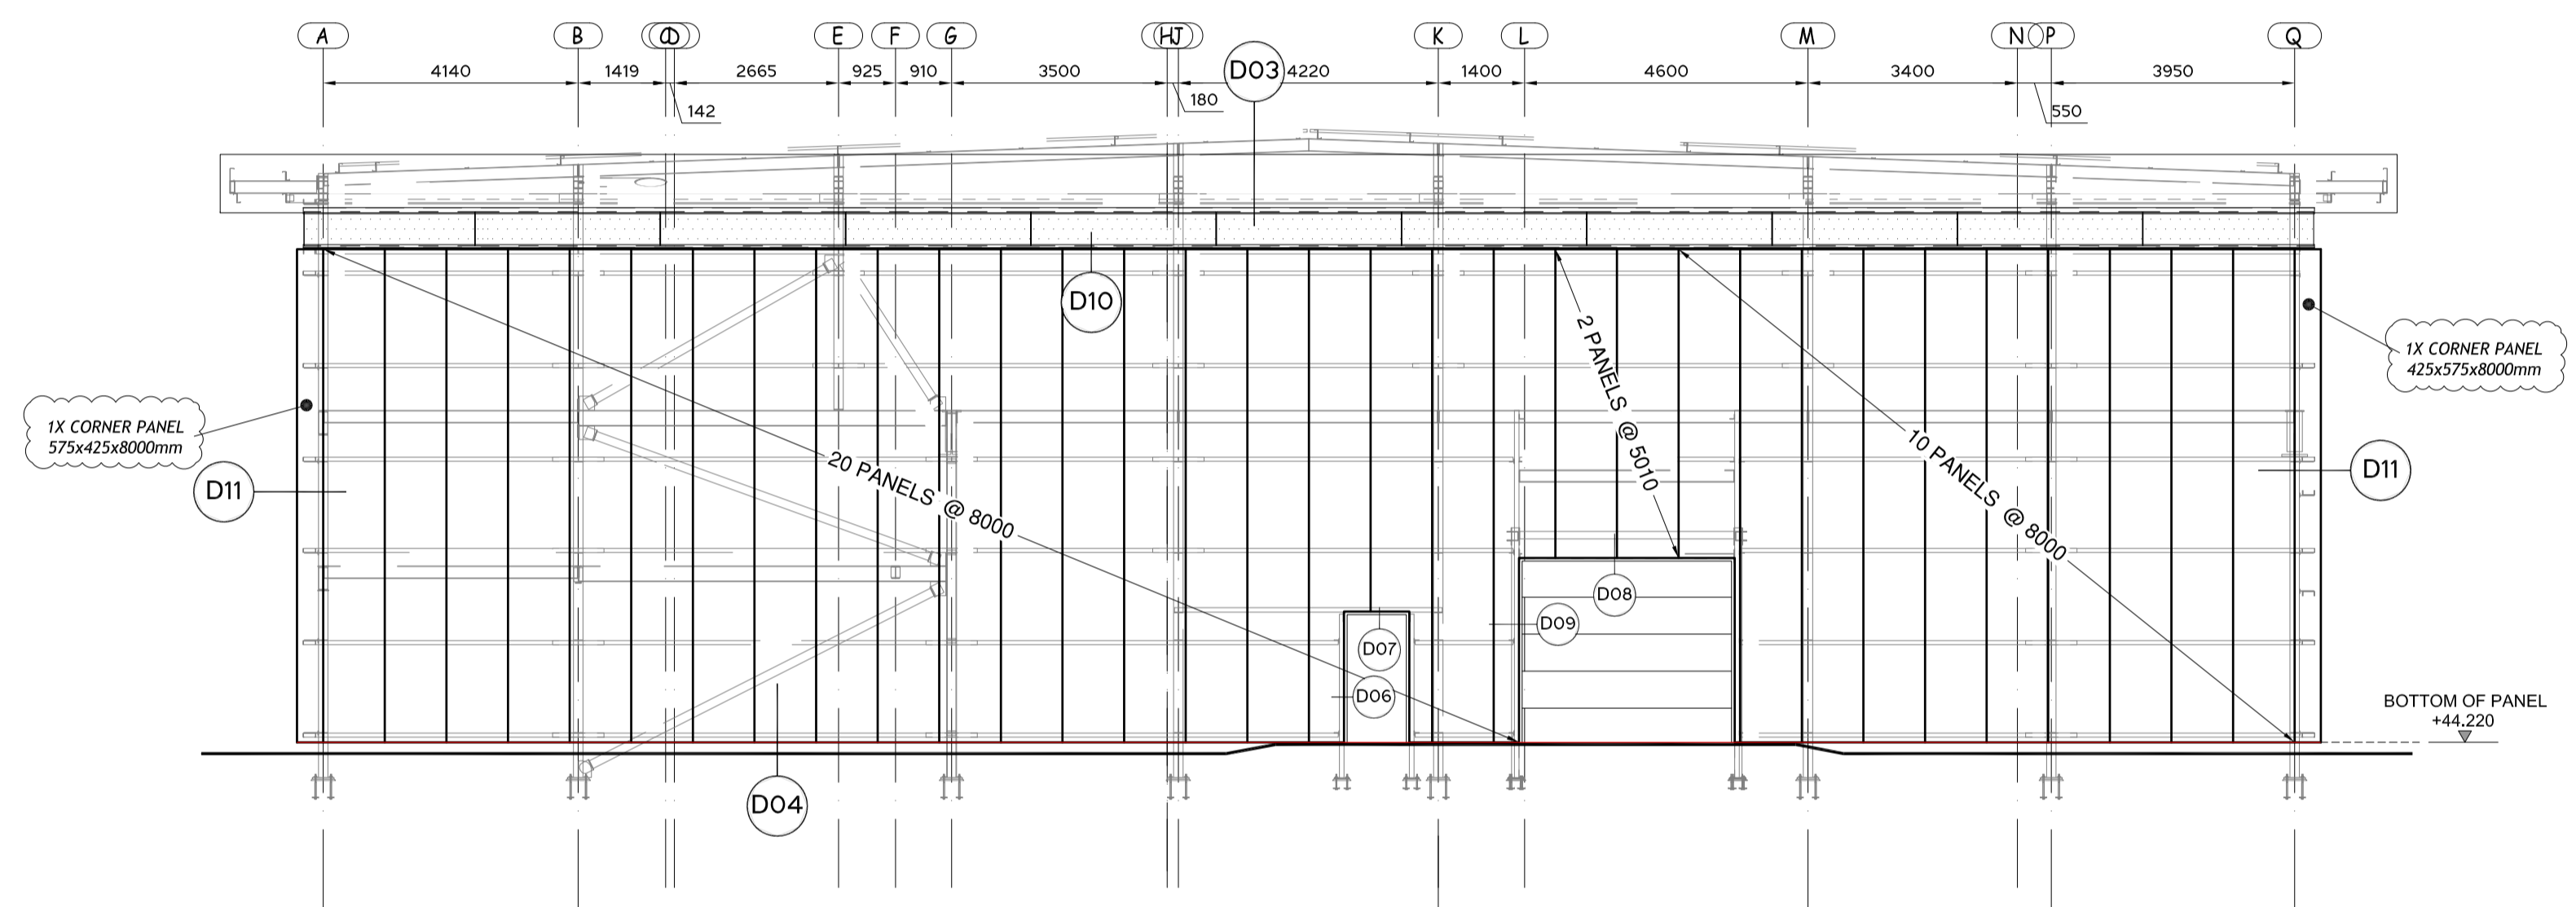

ELEVATION - GRID 13

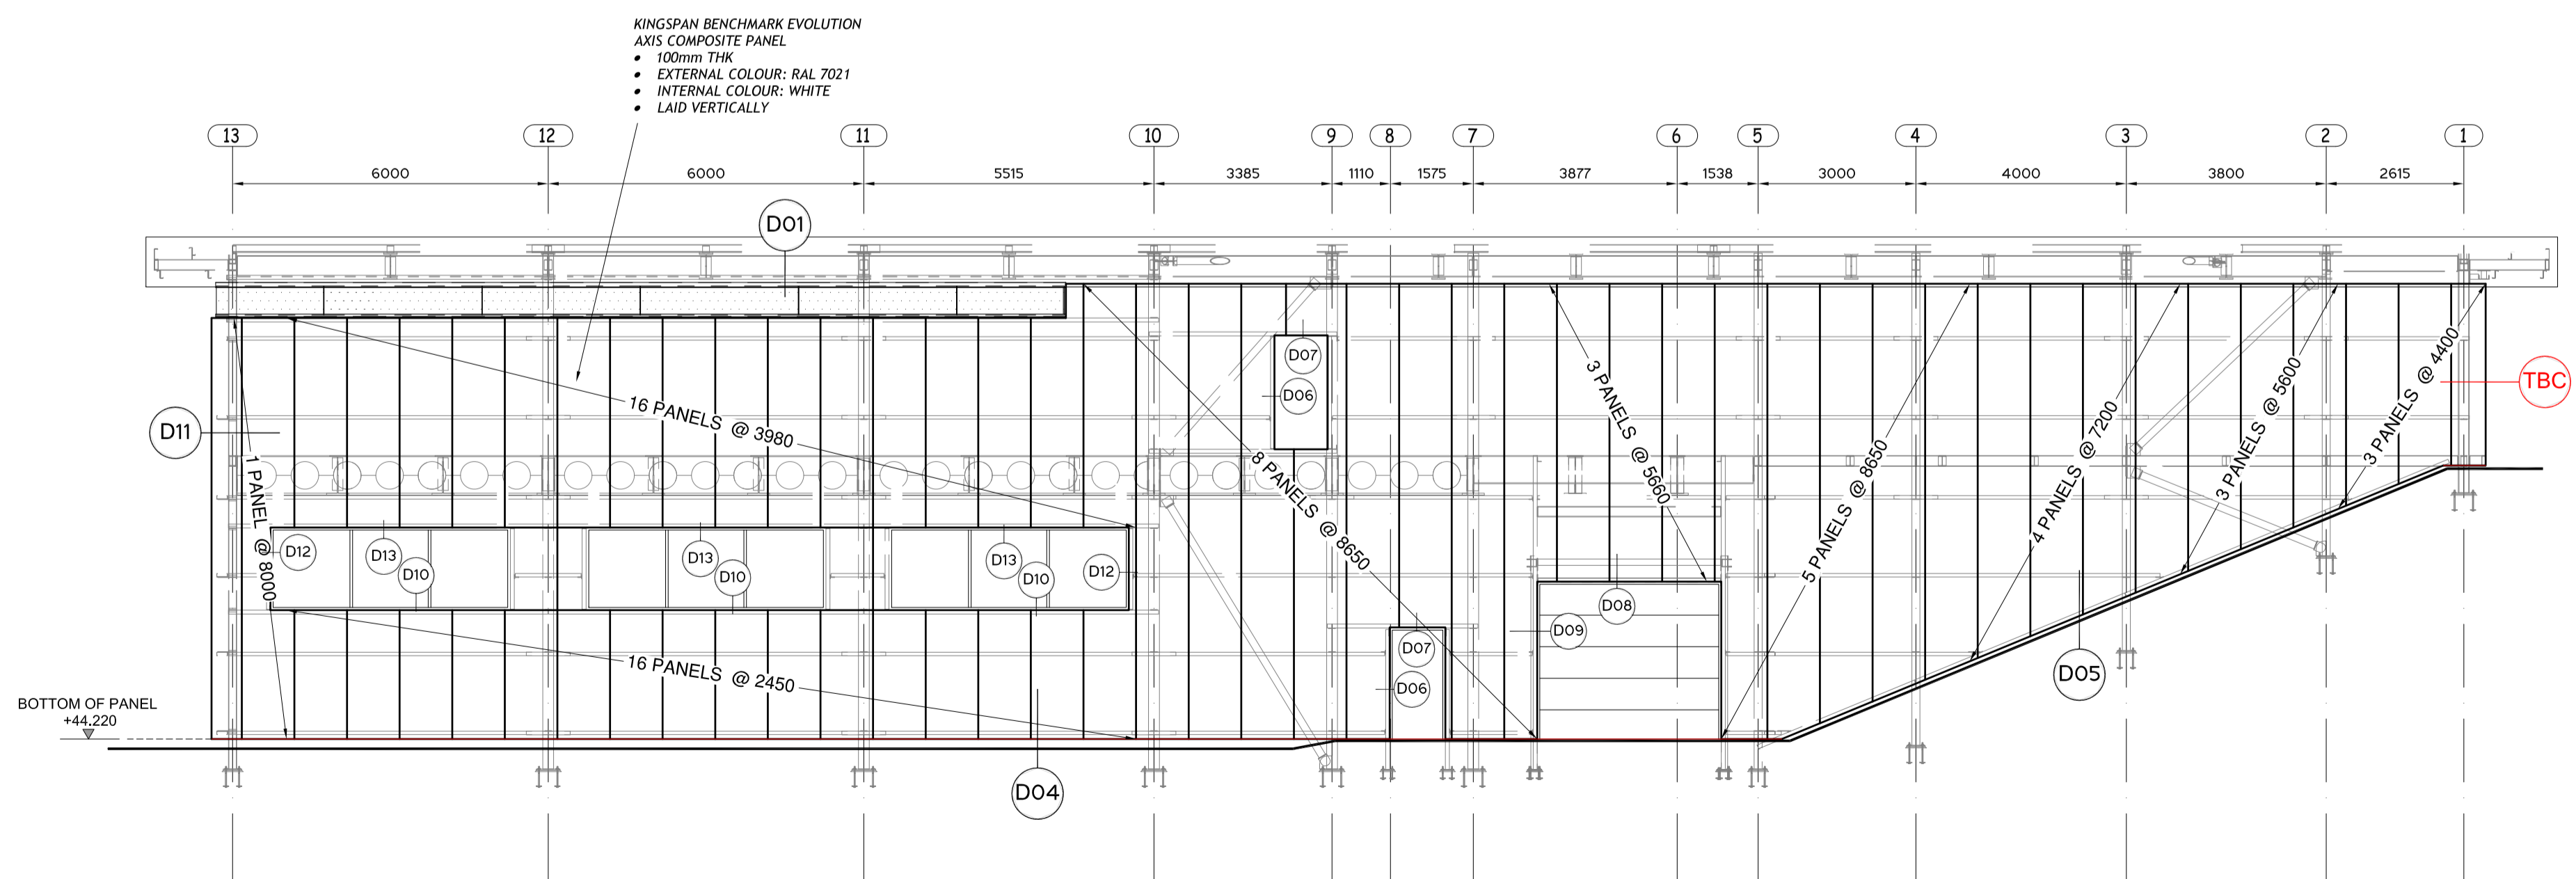

ELEVATION - GRID Q

REVISION / AUTHOR / CHECKER	AB-ISSUED AS BUILT - 04 JUL 16	RF	RF	DRAWN BY: RR	PROJECT TITLE: ASTON MARTIN	STATUS: AS BUILT
	C1-CONSTRUCTION ISSUE - 07 JAN 16	RR	RF			
	P3-PANEL CORNERS REVERSED - 06 JAN 16	RR	RF	SCALE @ A1: 1:75	DRAWING TITLE: CLADDING ELEVATIONS	REV: DRAWING NO: AB L03
	P2-REVISED TO RISK COMMENT - 10 DEC 15	RR	RF			
P1-ISSUED FOR APPROVAL - 25 NOV 15	RR	RF				