




ELEVATION ON GRIDLINE B

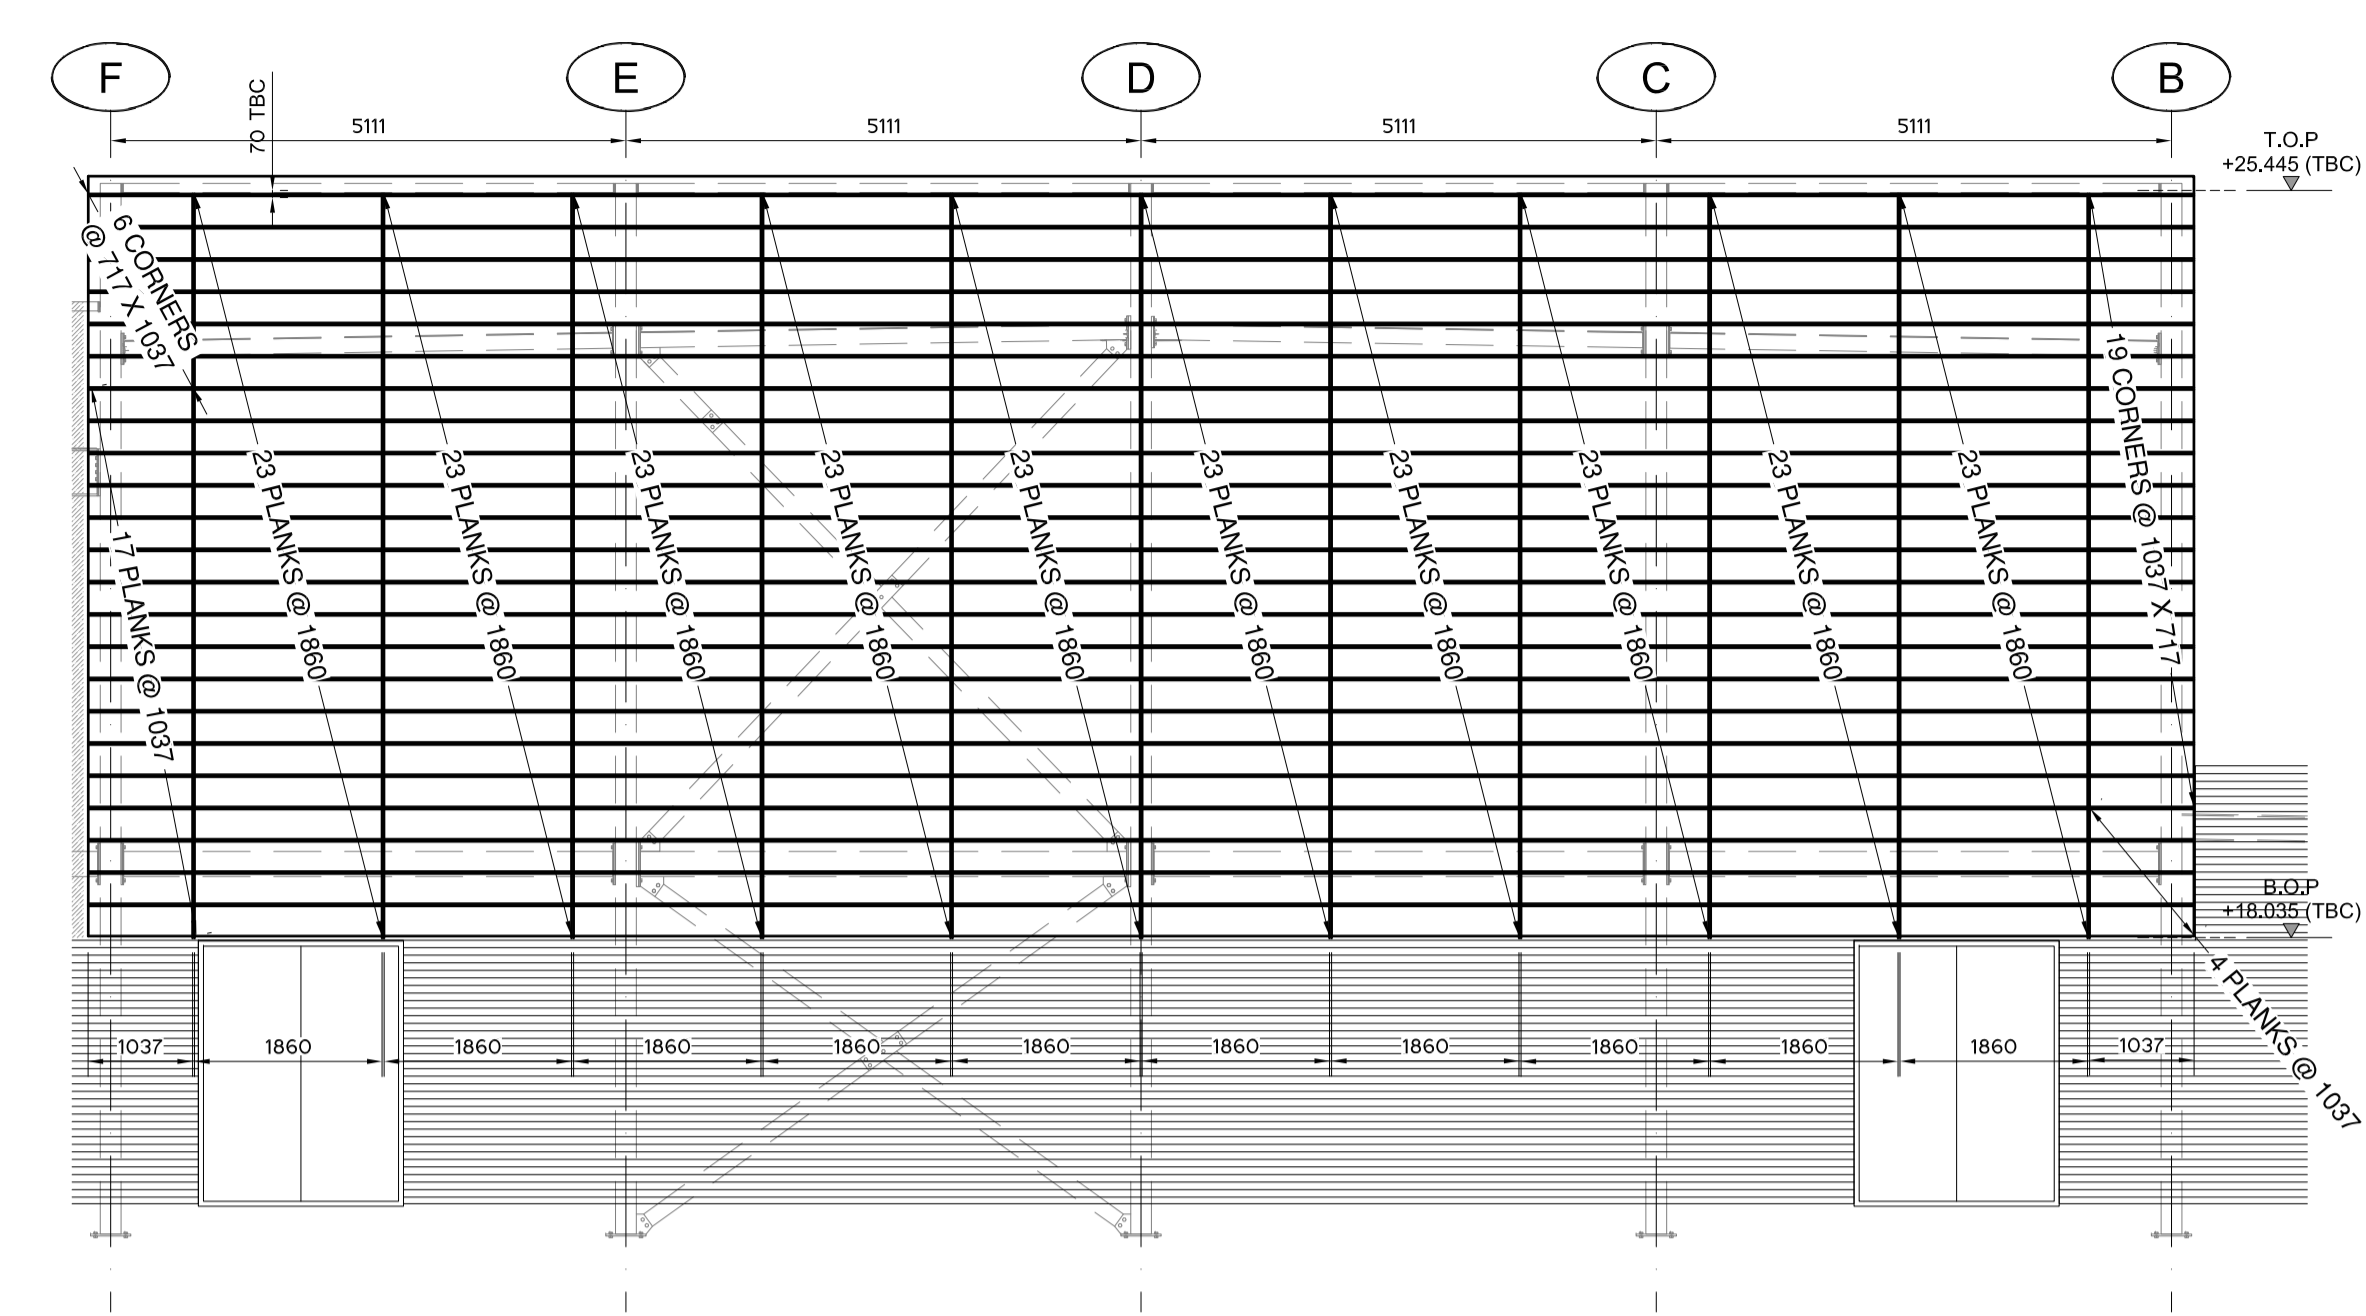


ELEVATION ON GRIDLINE 1

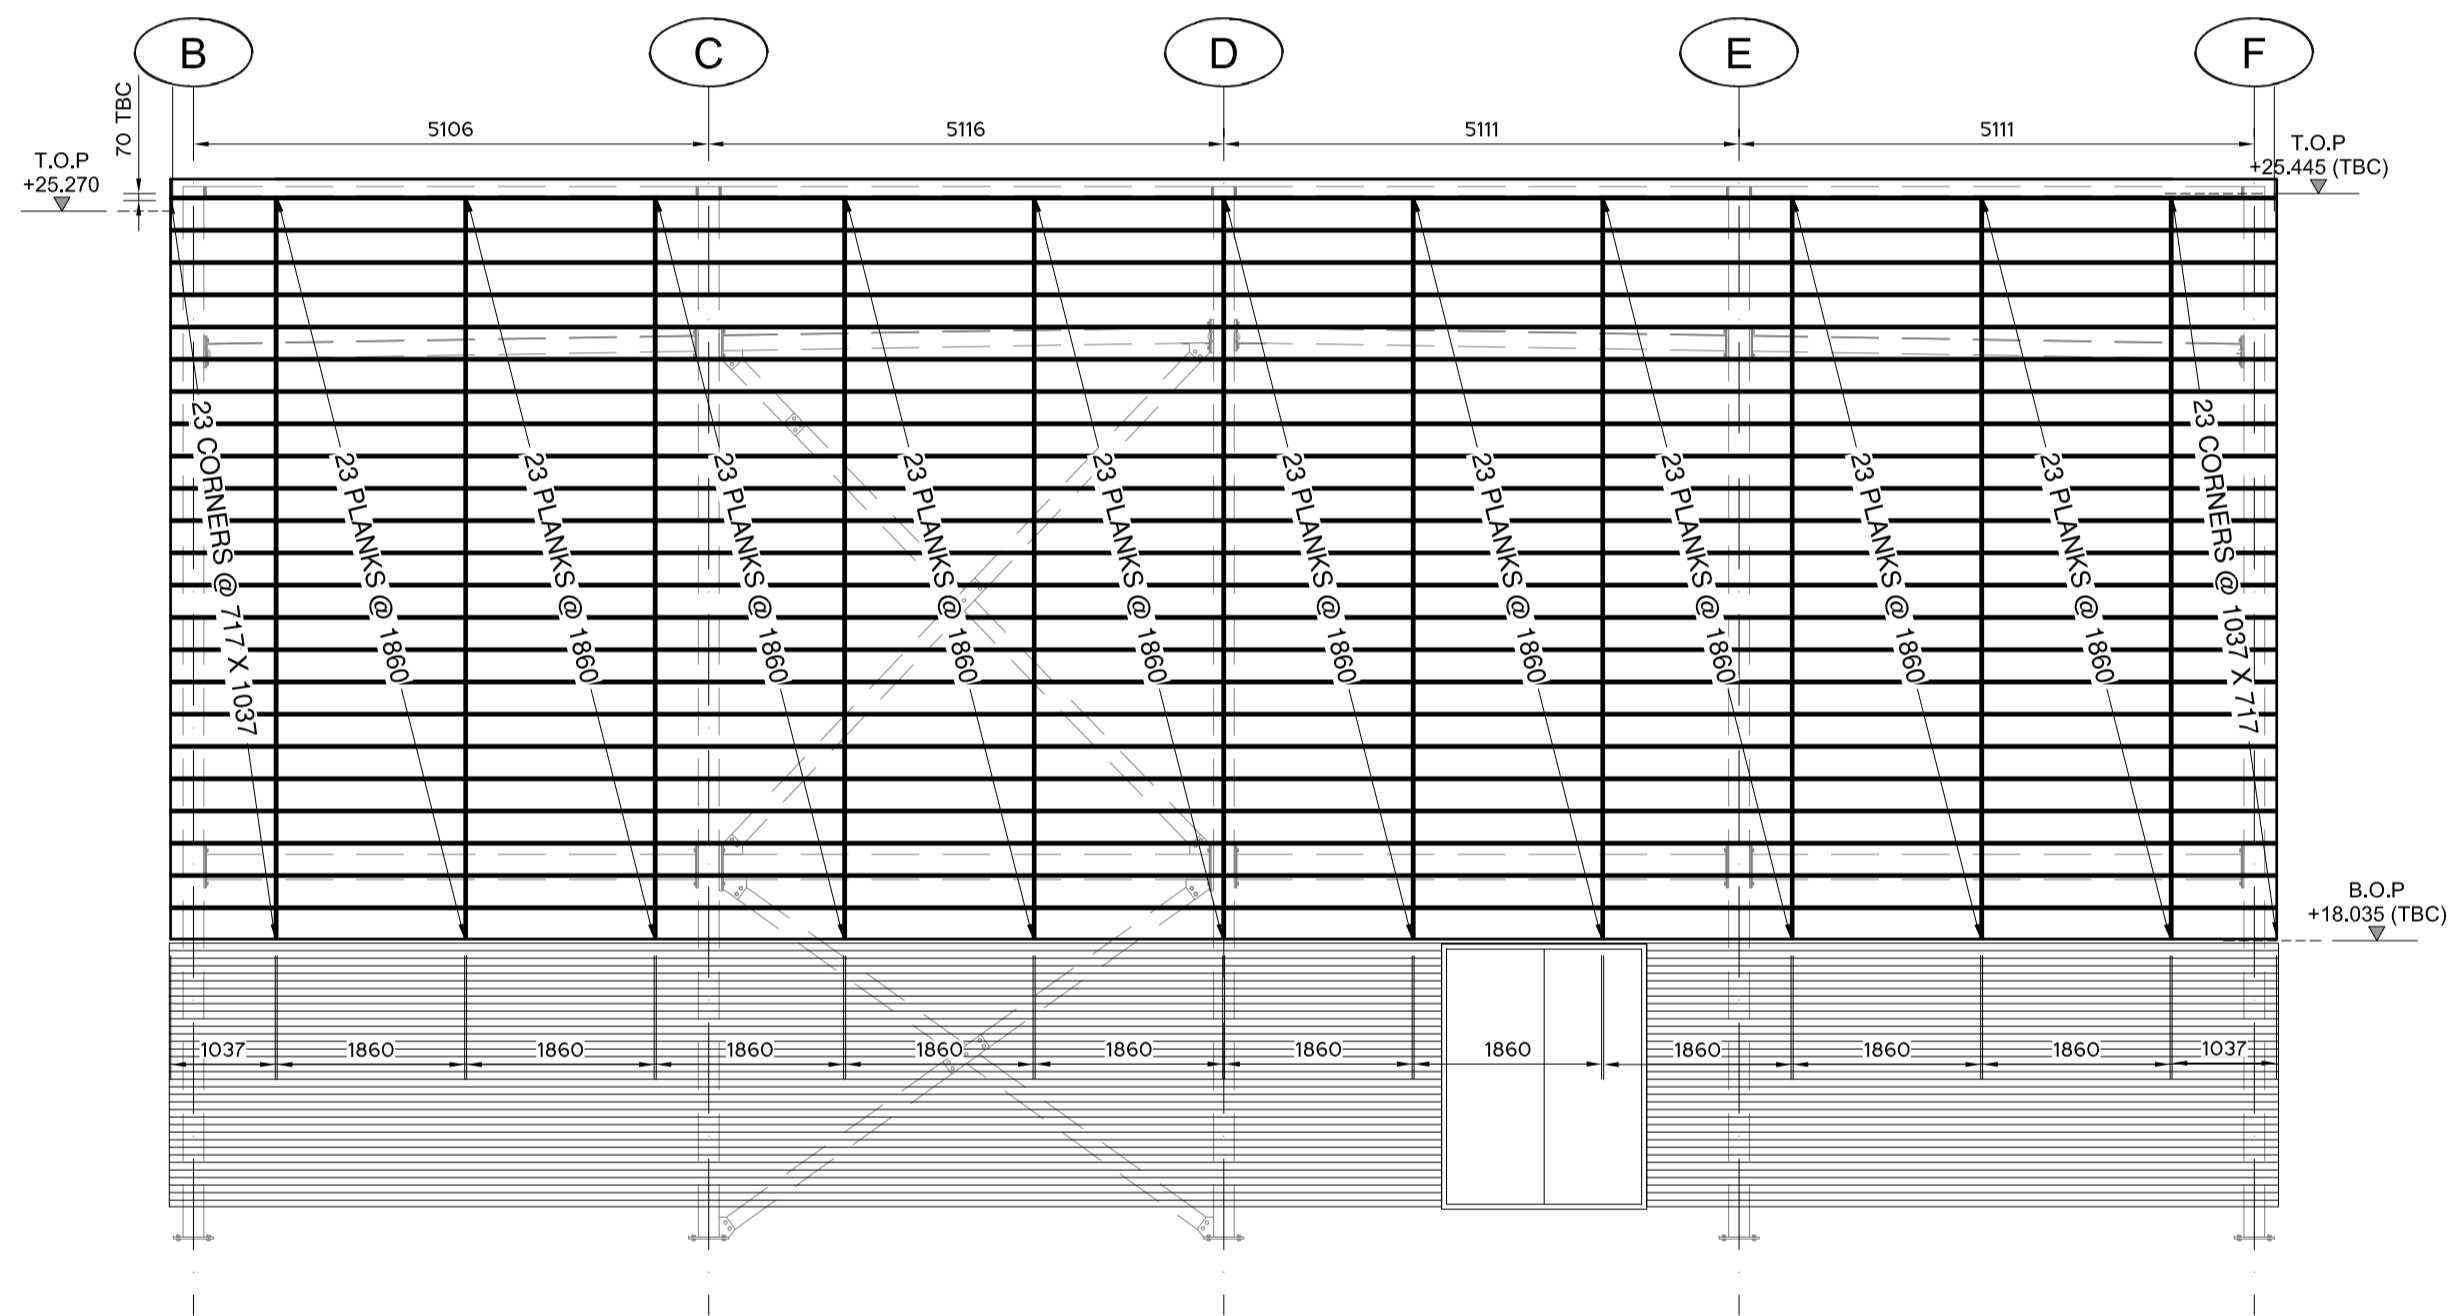

ELEVATION ON GRIDLINE 11

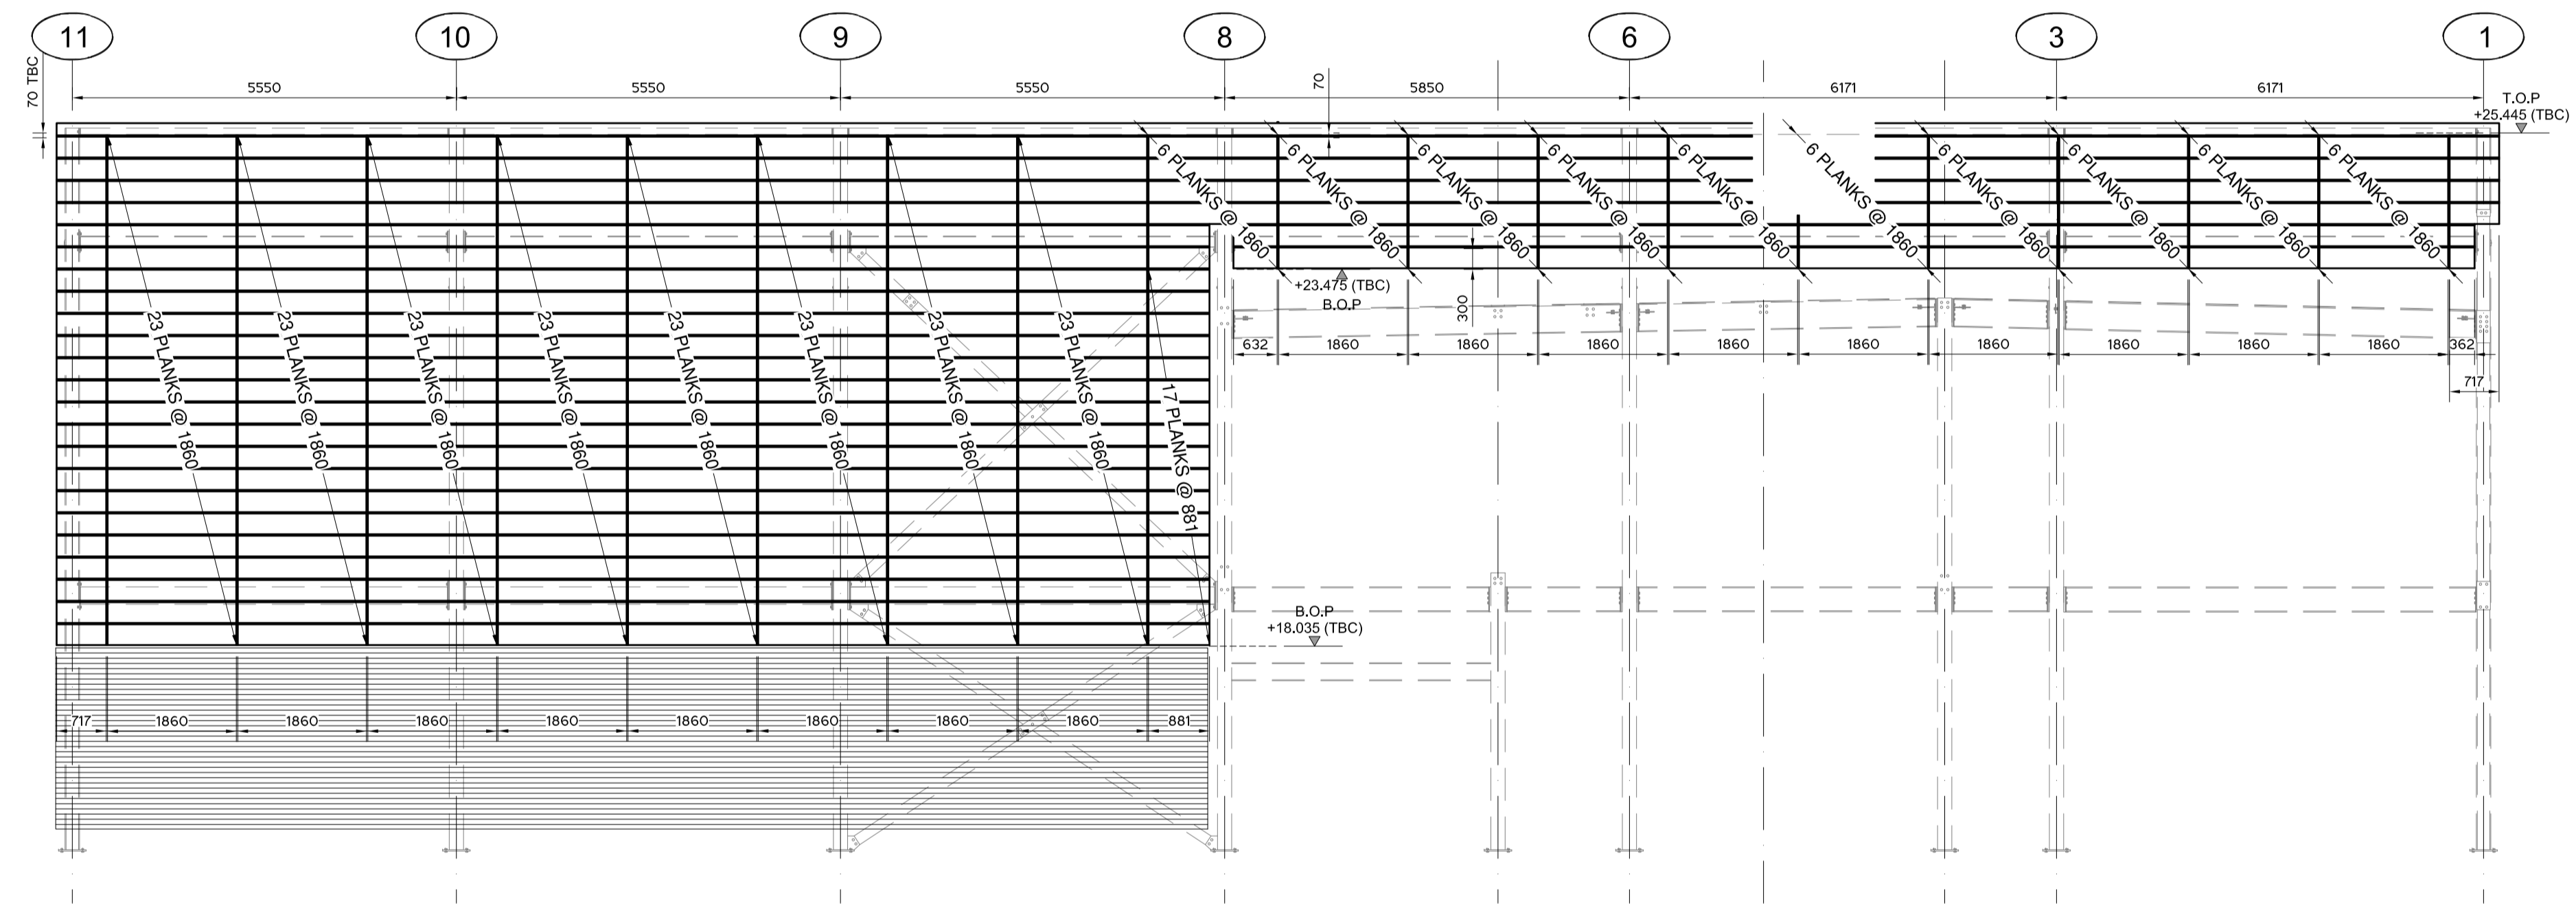

ELEVATION ON GRIDLINE F

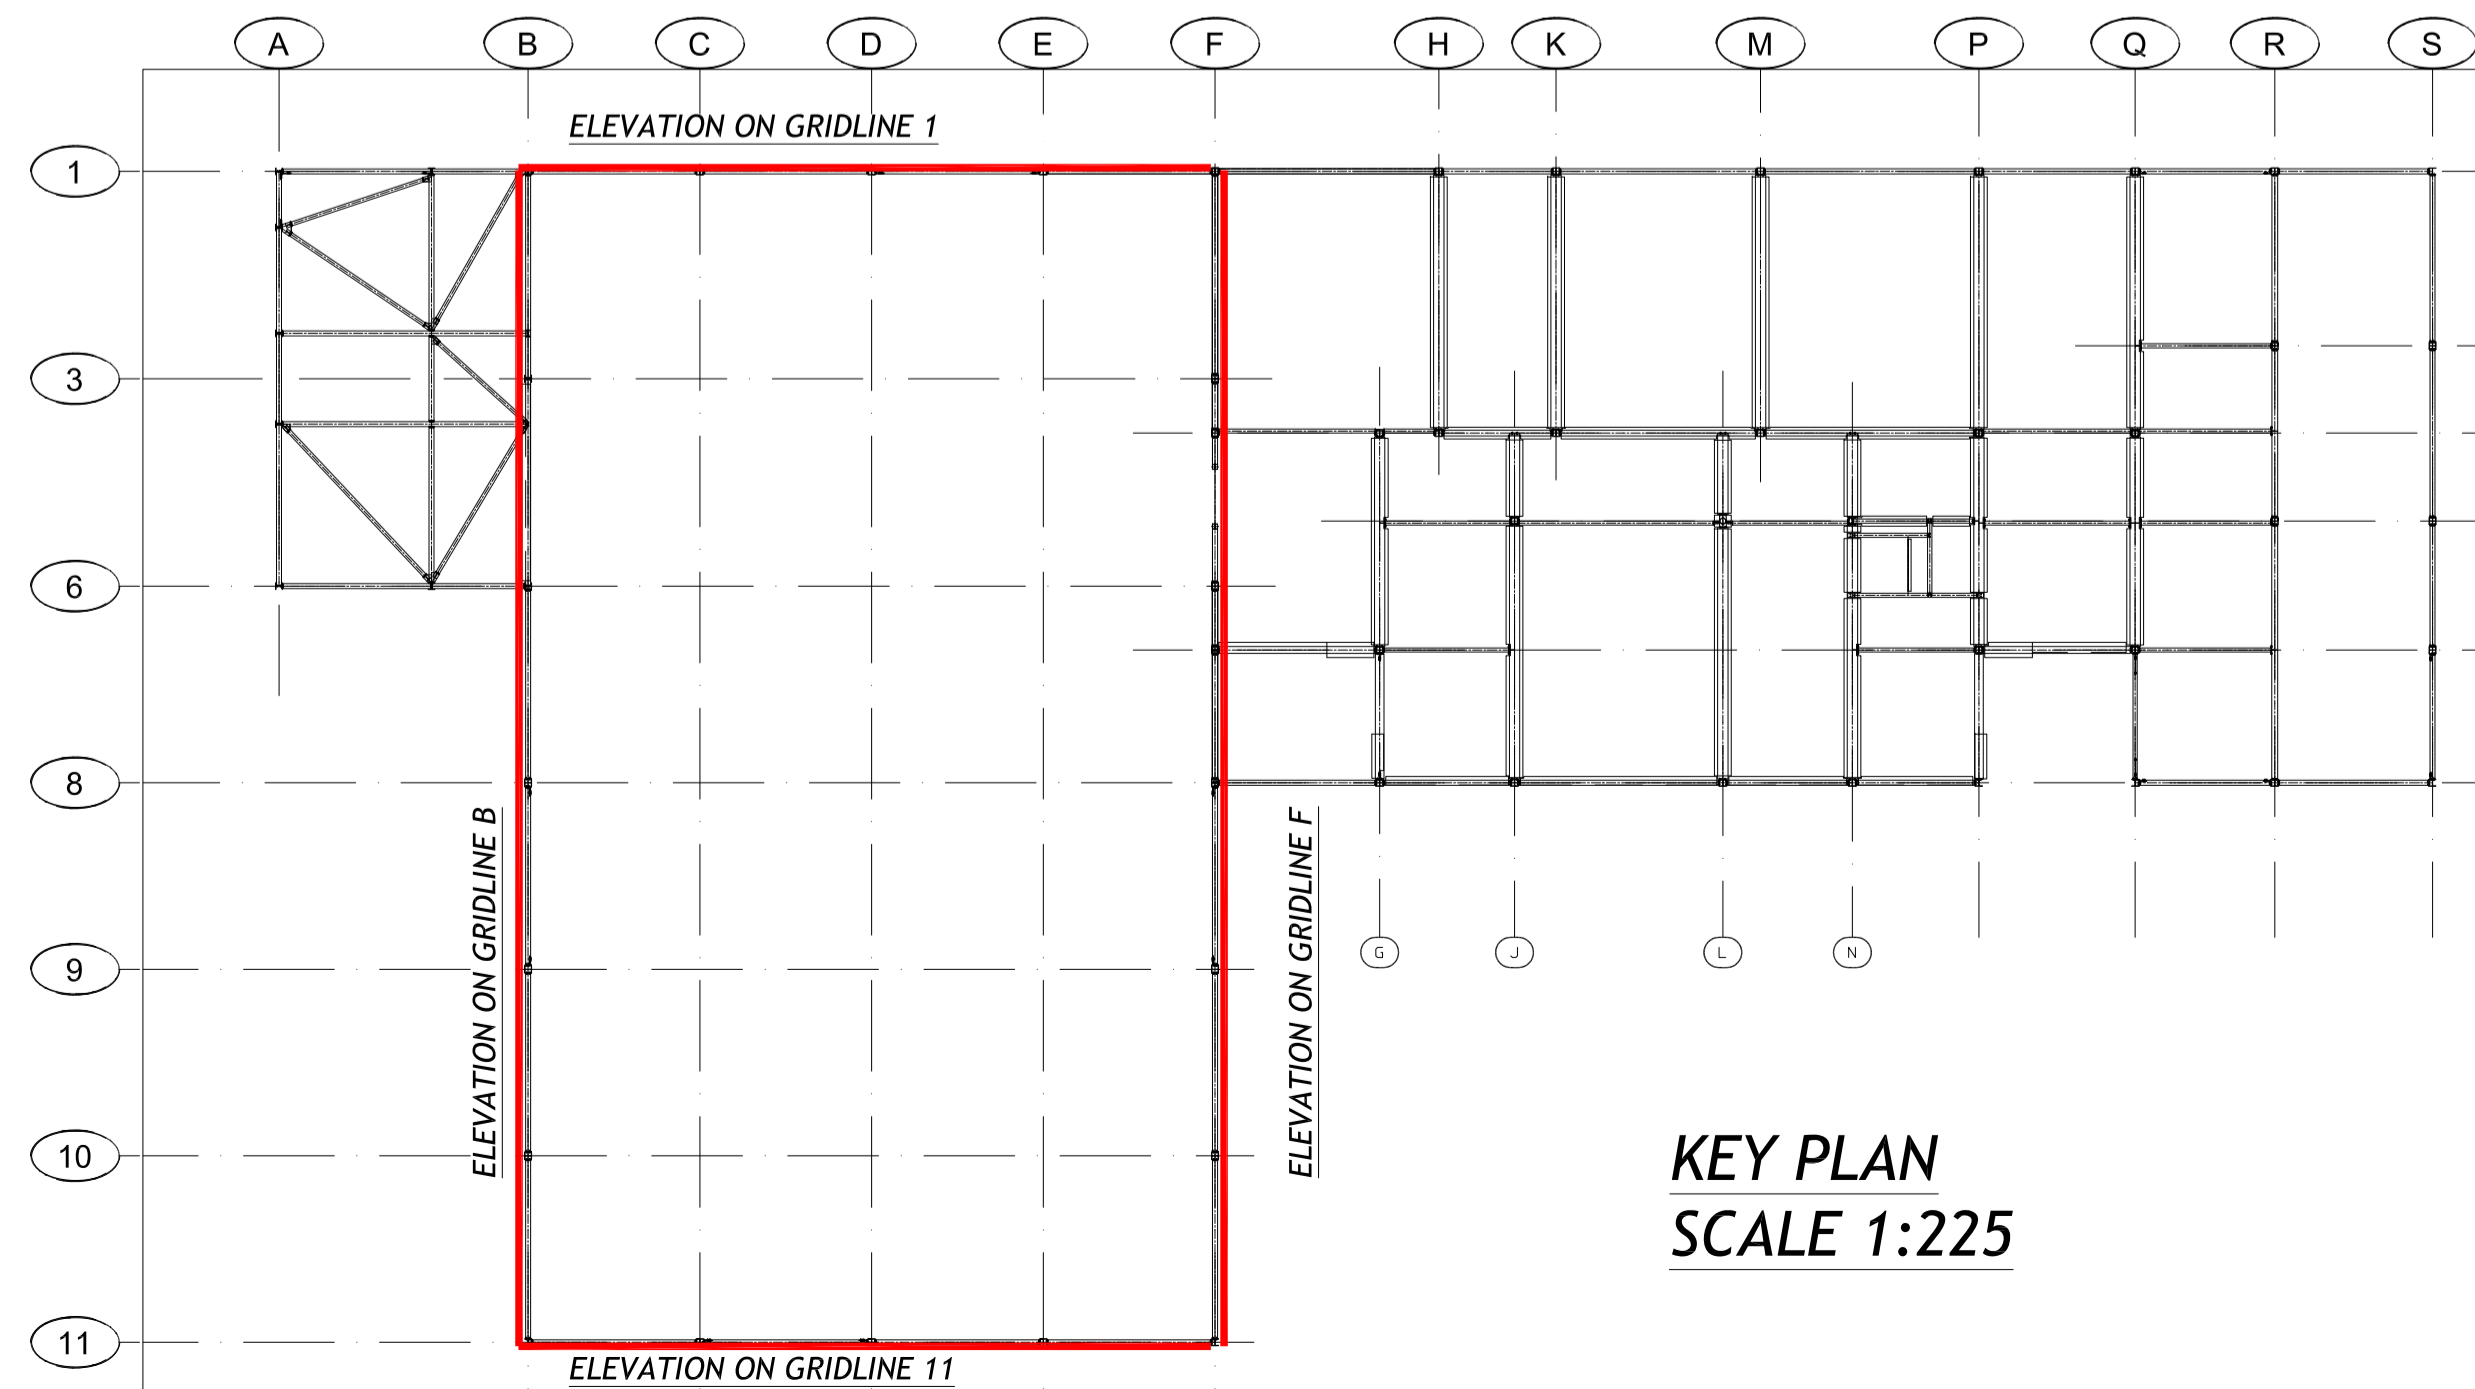

KEY PLAN
SCALE 1:225

NOTE: ALL PLANK JOINT GAPS ARE 20mm
ALL PLANKS ARE 300mm HIGH UNLESS
OTHERWISE STATED.

AS-ISSUED AS BUILT - 19 May 16	RF	RF	DRAWN BY: AL	PROJECT TITLE: THOMAS KNYVETT / BROOKLANDS COLLEGE	STATUS: AS BUILT
C1 - CONSTRUCTION ISSUE - 08 MAR 16	RR	RF	SCALE @ A1: 1:75	DRAWING TITLE: KINGSPAN PLANK LAYOUT	REV: AB
C1 - CONSTRUCTION ISSUE - 08 MAR 16	RR	RF			DRAWING NO: L07
P2 - PLANK LENGTHS ADDED - 29 FEB 16	RR	RF			
P1 - ISSUED FOR APPROVAL - 12 FEB 16	RR	RF			
REVISION / AUTHOR / CHECKER					