




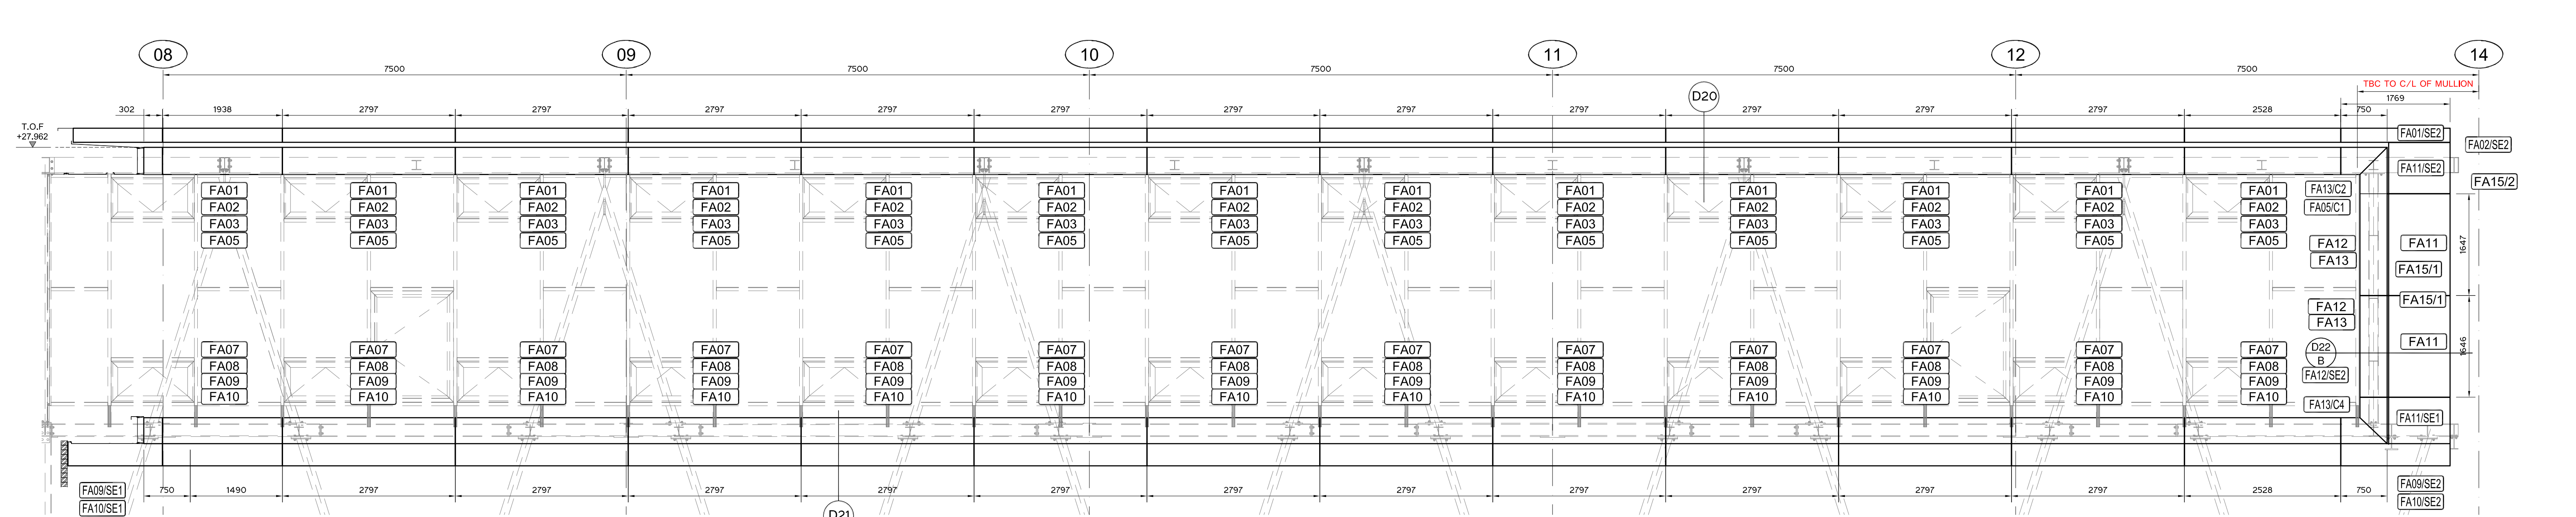


ELEVATION ON GRIDLINE M2

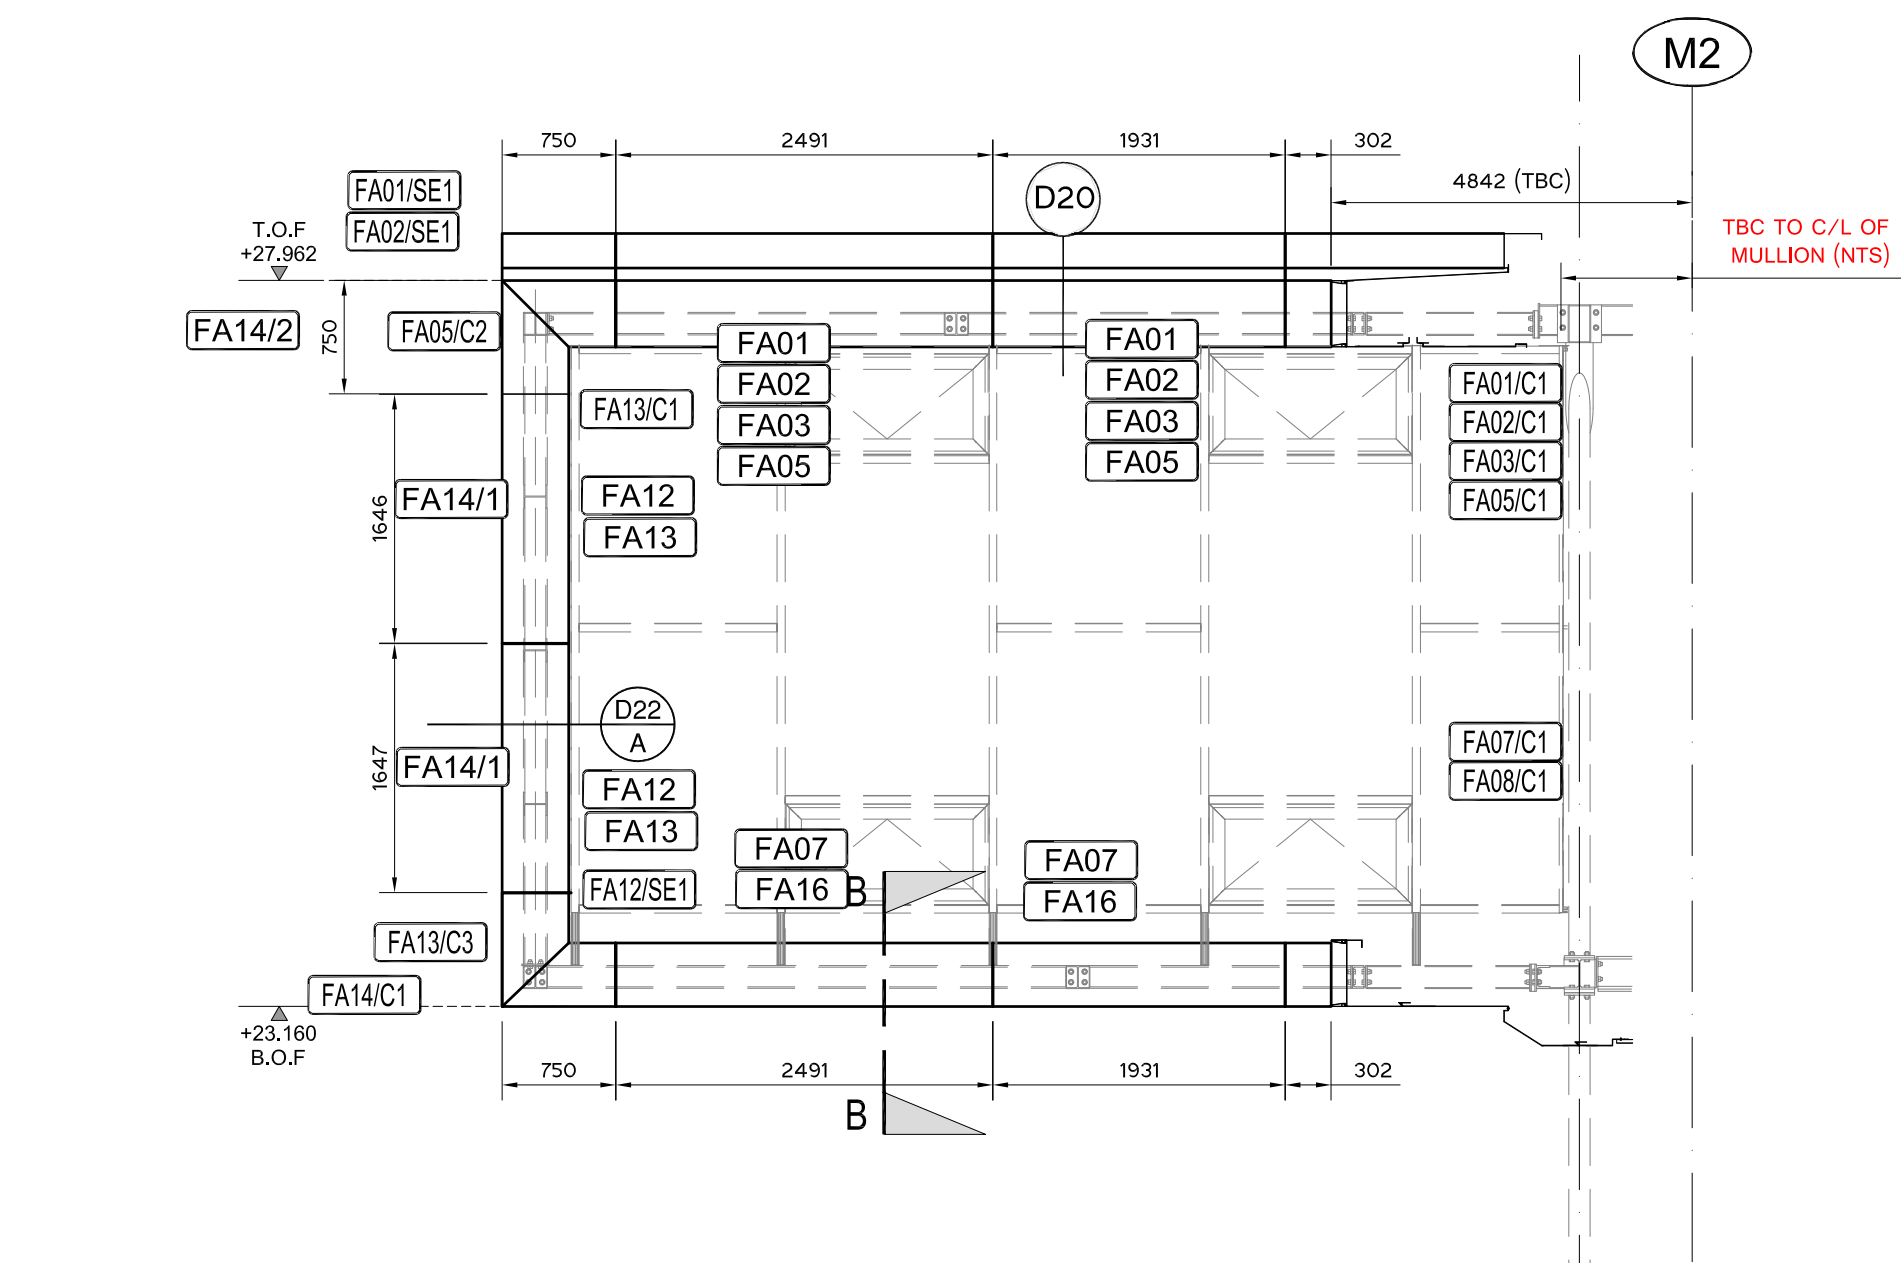

ELEVATION ON GRIDLINE 08

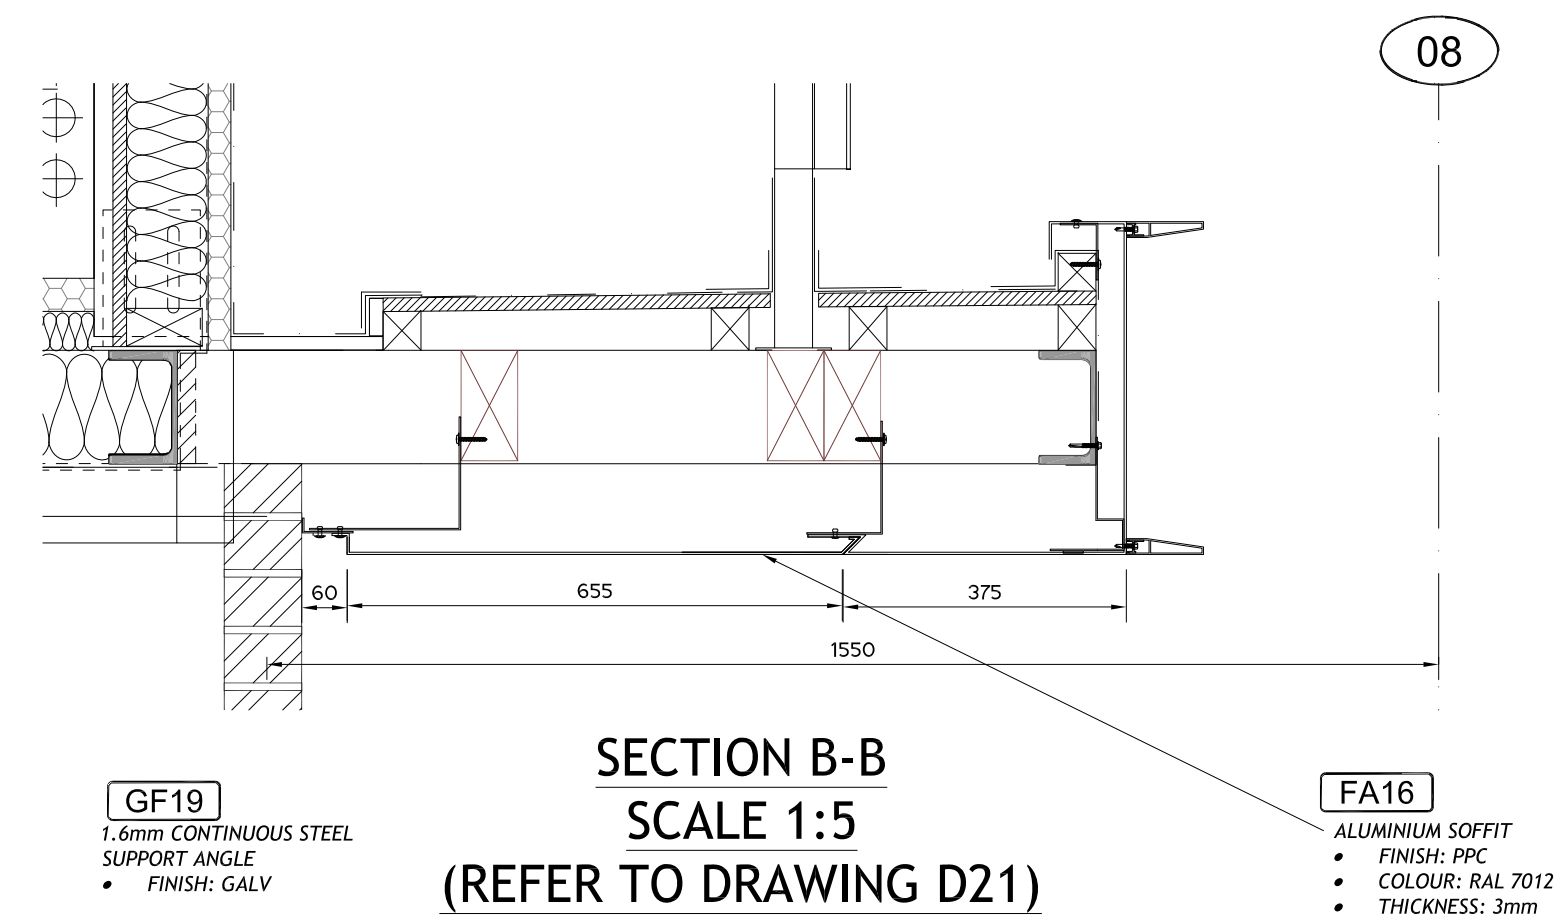

SECTION B-B
SCALE 1:5
(REFER TO DRAWING D21)

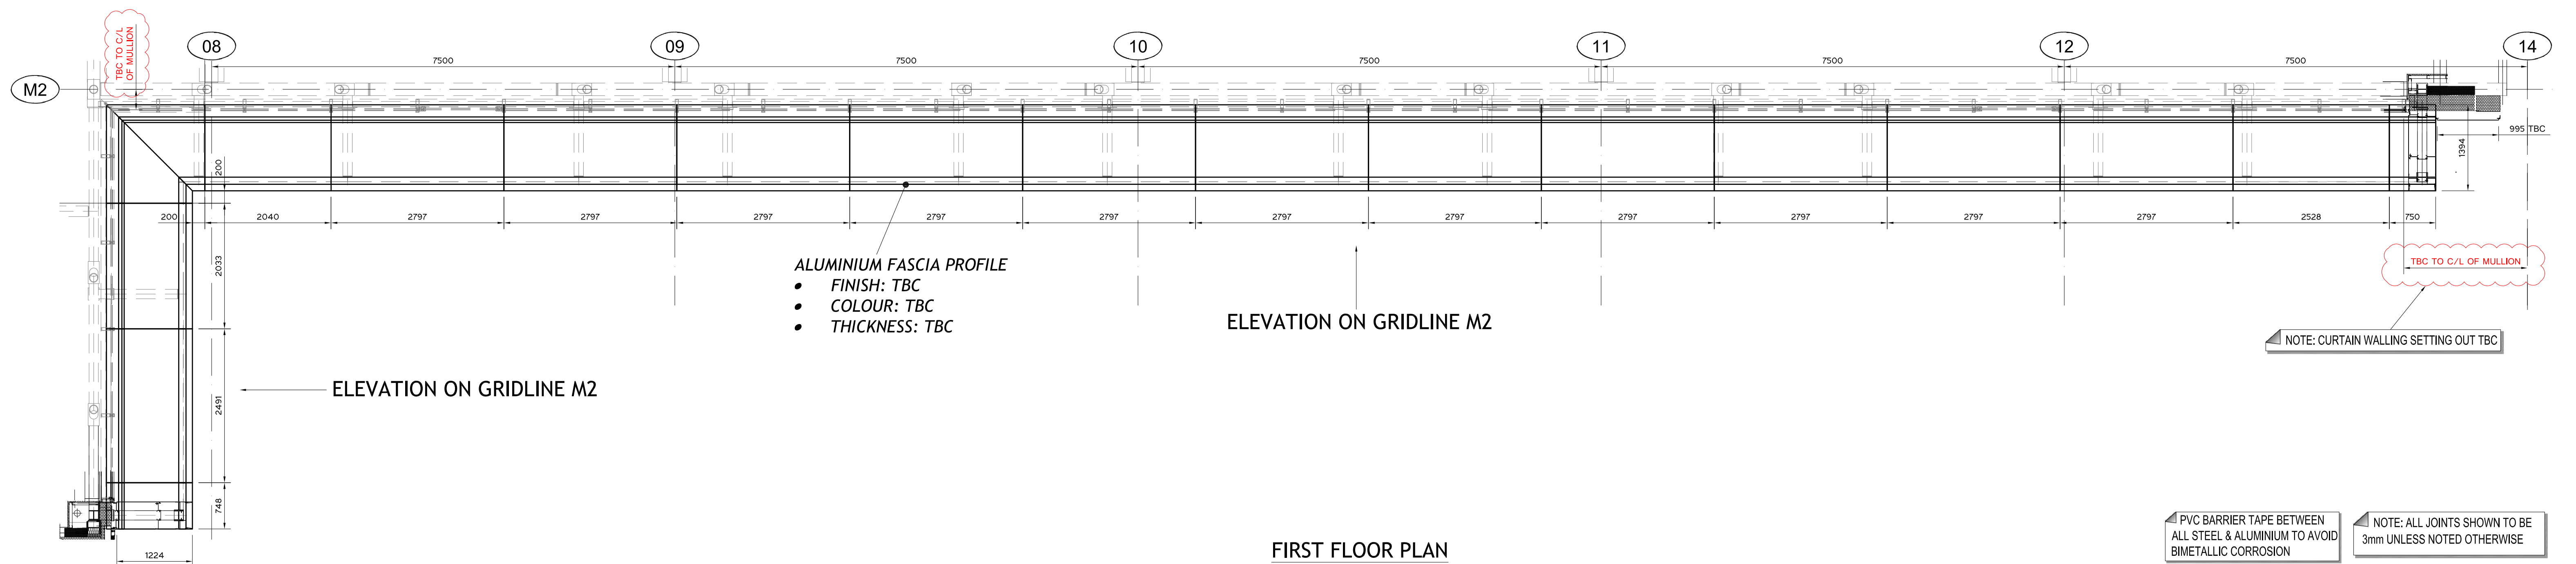

ELEVATION ON GRIDLINE M2

ELEVATION ON GRIDLINE M2

ALUMINIUM FASCIA PROFILE

- FINISH: TBC
- COLOUR: TBC
- THICKNESS: TBC

NOTE: CURTAIN WALLING SETTING OUT TBC

FIRST FLOOR PLAN

PVC BARRIER TAPE BETWEEN
ALL STEEL & ALUMINIUM TO AVOID
BIMETALLIC CORROSION

NOTE: ALL JOINTS SHOWN TO BE
3mm UNLESS NOTED OTHERWISE

REVISION / AUTHOR / CHECKER	AS-BUILT AS BUILT - 08 MAR 17	RF	RF	DRAWN BY: AL	PROJECT TITLE: EASTLEIGH COLLEGE NEW BLOCK G	STATUS: AS BUILT	
	C2 - REFERENCES ADDED - 5 JAN 17	RR	RF				
	C1 - CONSTRUCTION ISSUE - 4 JAN 17	RR	RF				
	P4 - ADDITIONAL FASCIAS ADDED - 23 NOV 16	RR	RF				
REVISION / AUTHOR / CHECKER	P3 - ADDITIONAL FASCIAS ADDED - 21 NOV 16	RR	RF	SCALE @ A1: 1:100	DRAWING TITLE: PICTURE FRAME DRAWINGS	REV: AB	DRAWING NO: L03
	P2 - REVISED TO COMMENTS - 14 NOV 16	RR	RF				
	P1 - ISSUED FOR APPROVAL - 11 OCT 16	AL	RR				