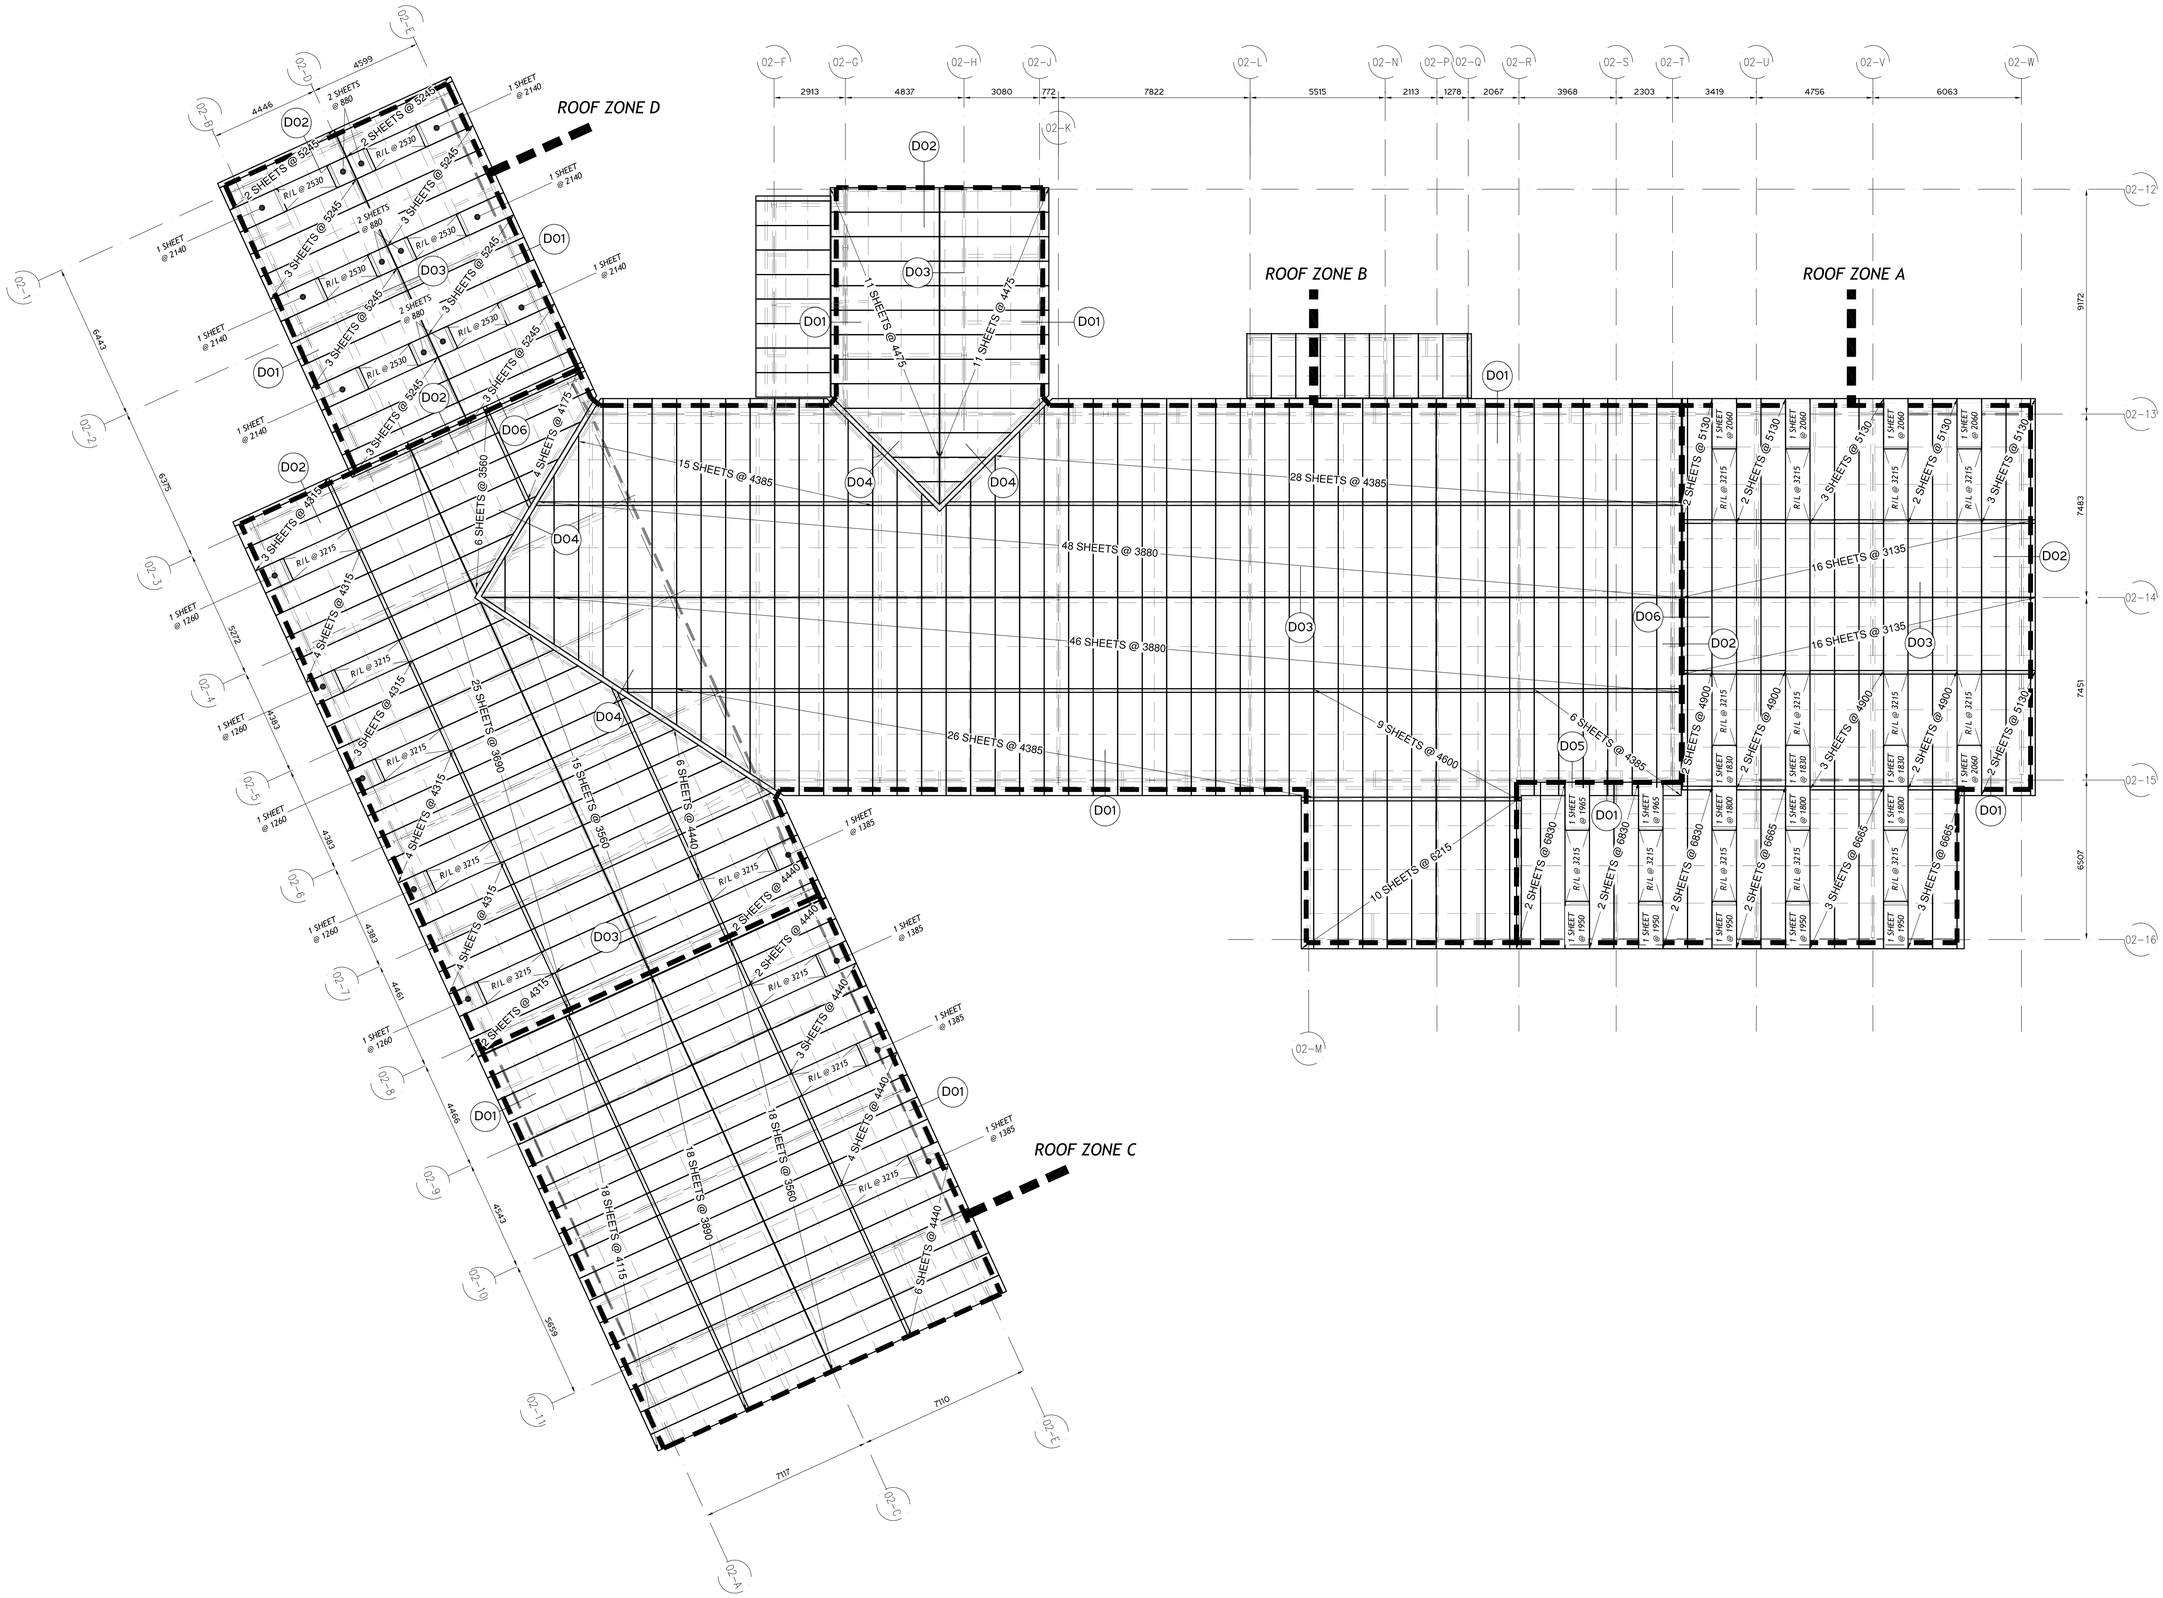

ZONE 2

BMC / Bowmer & Kirkland	REVISION / AUTHOR / CHECKER			DRAWN BY: PL	PROJECT TITLE: BROOSKBY MELTON COLLEGE - ZONE 2	STATUS: AS BUILT
	AB - ISSUED AS BUILT - 06 JAN 14	AL	PL	SCALE @ A1: 1:125	DRAWING TITLE: ROOF TOPSHEET LAYOUT	REV: AB	DRAWING NO: 290-Z2-L02
	C1 - ISSUED FOR CONSTRUCTION - 09 JUNE 14	PL	PL			
	P1-ISSUED FOR APPROVAL - 29 MAY 14	PL	PL			

Drawing file: