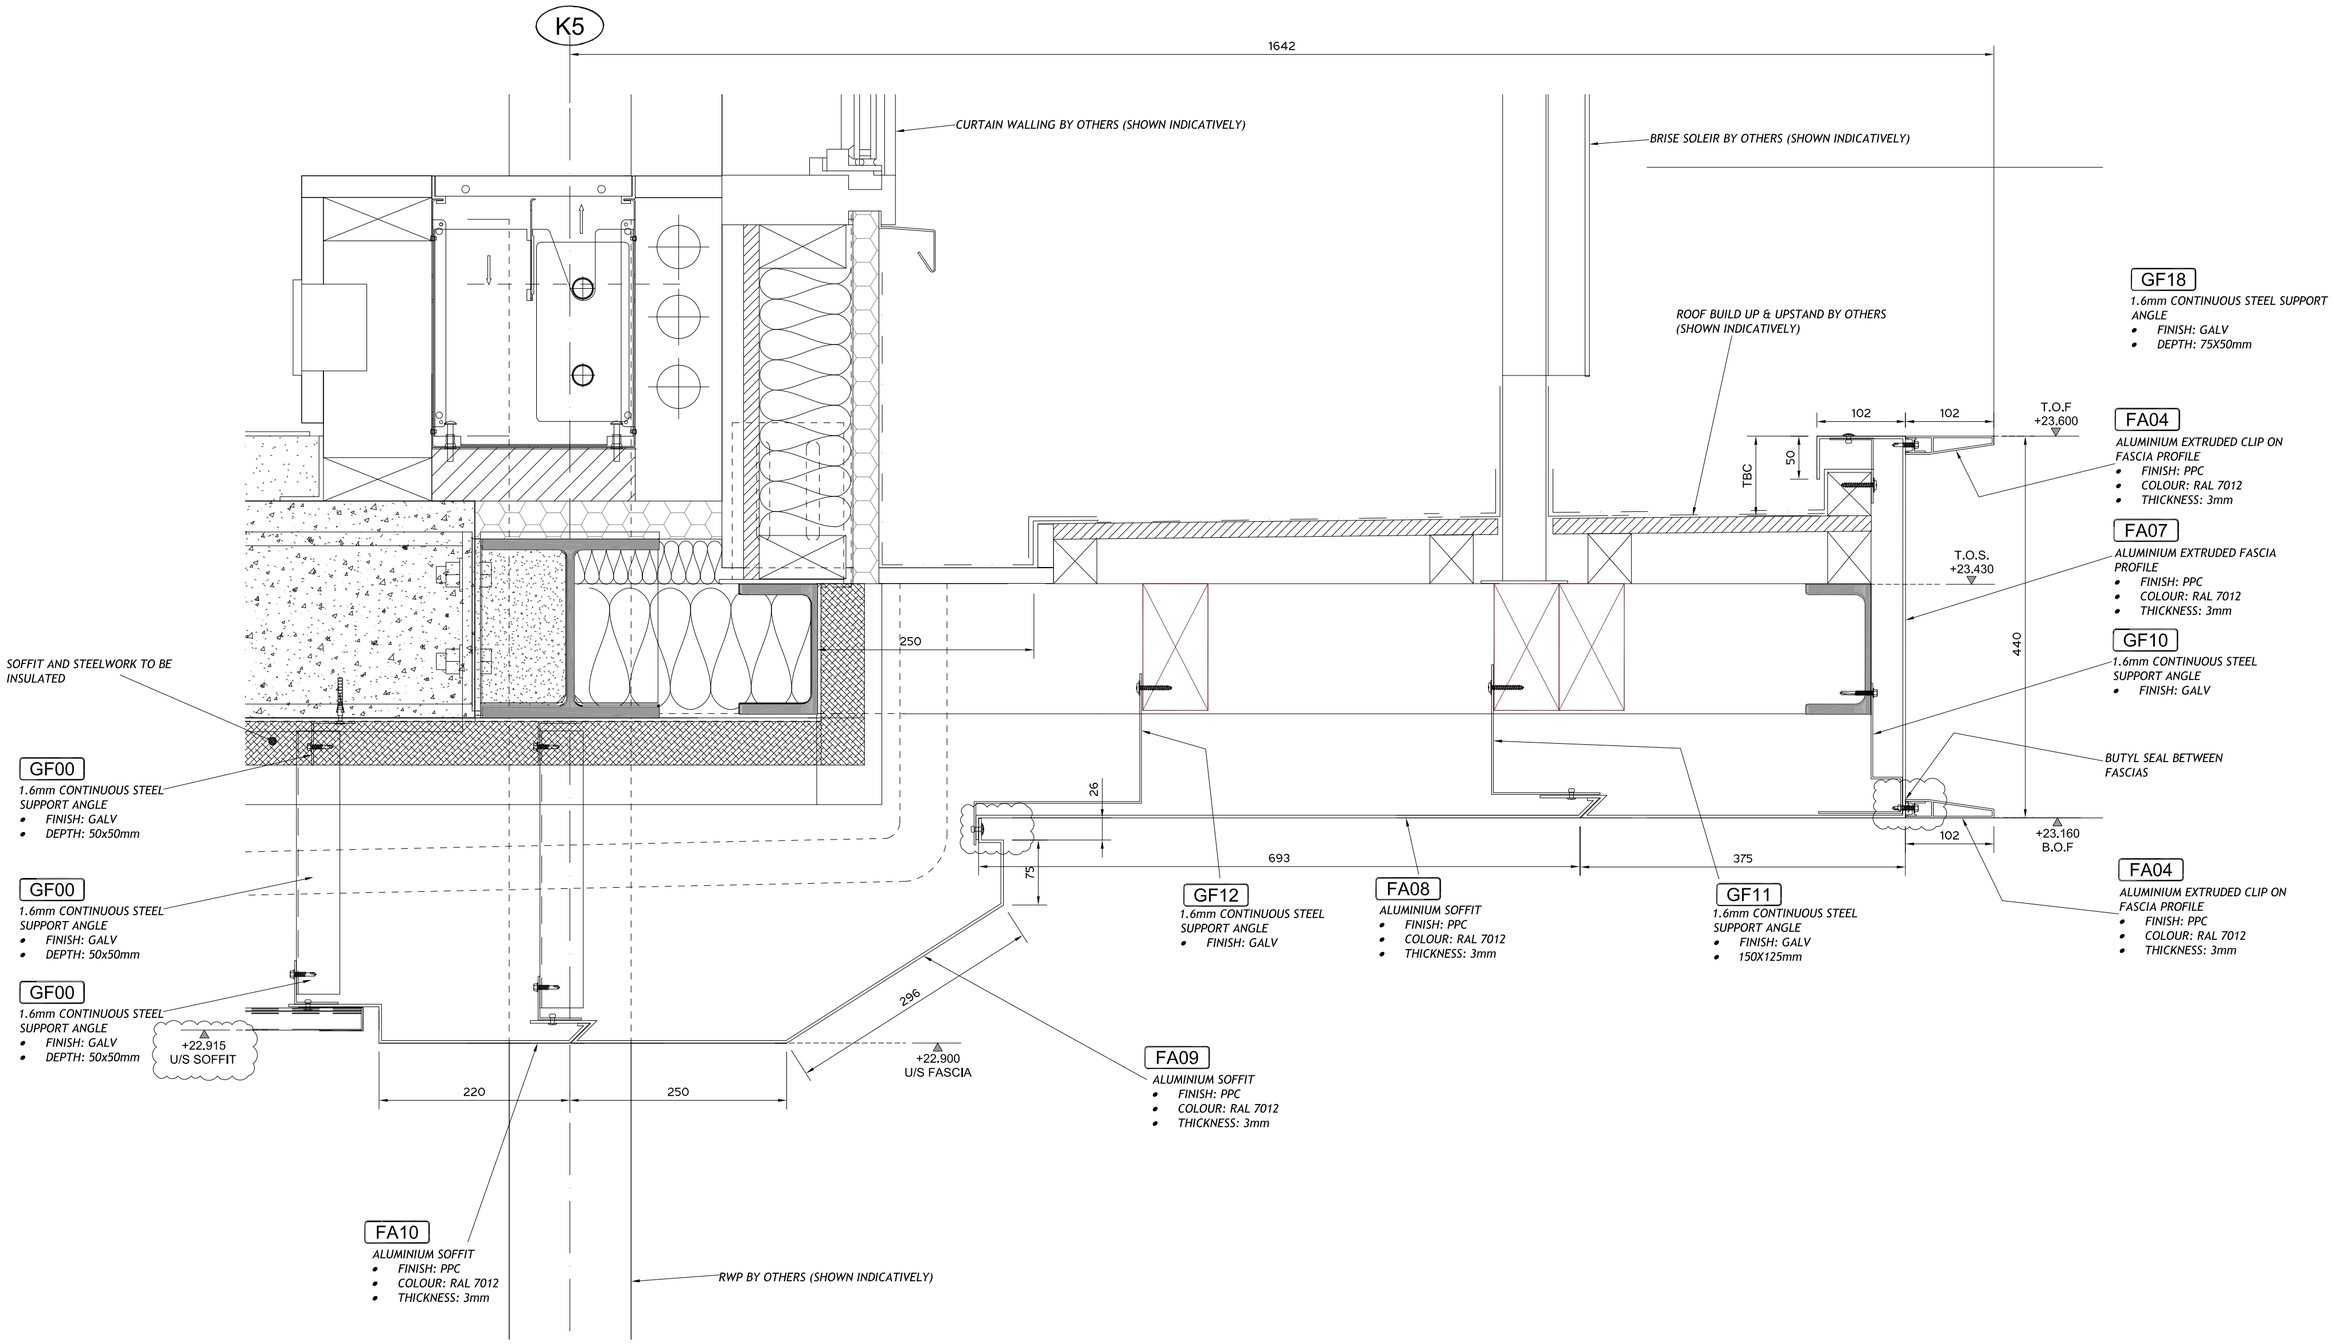

REVISION / AUTHOR / CHECKER		
AB-ISSUED AS BUILT - 09 Mar 17	RF	RF
P6 - REVISED TO COMMENTS - 15 DEC 16	RR	RF
P5 - REVISED TO LATEST COMMENTS - 6 DEC 16	RR	RF
P4 - REVISED TO COMMENTS AND FIXINGS ADDED - 23 NOV 16	RR	RF
P3 - SOFFIT LEVEL REVISED TO MATCH D15 - 21 NOV 16	RR	RF
P2 - REVISED TO COMMENTS - 14 NOV 16	RR	RF
P1-ISSUED FOR APPROVAL - 11 OCT 16	AL	RR

DRAWN BY: AL	PROJECT TITLE: EASTLEIGH COLLEGE NEW BLOCK G	STATUS: AS BUILT	
SCALE @ A2: 1:5	DRAWING TITLE: WALKWAY CILL DETAIL	REV: AB	DRAWING NO: D21